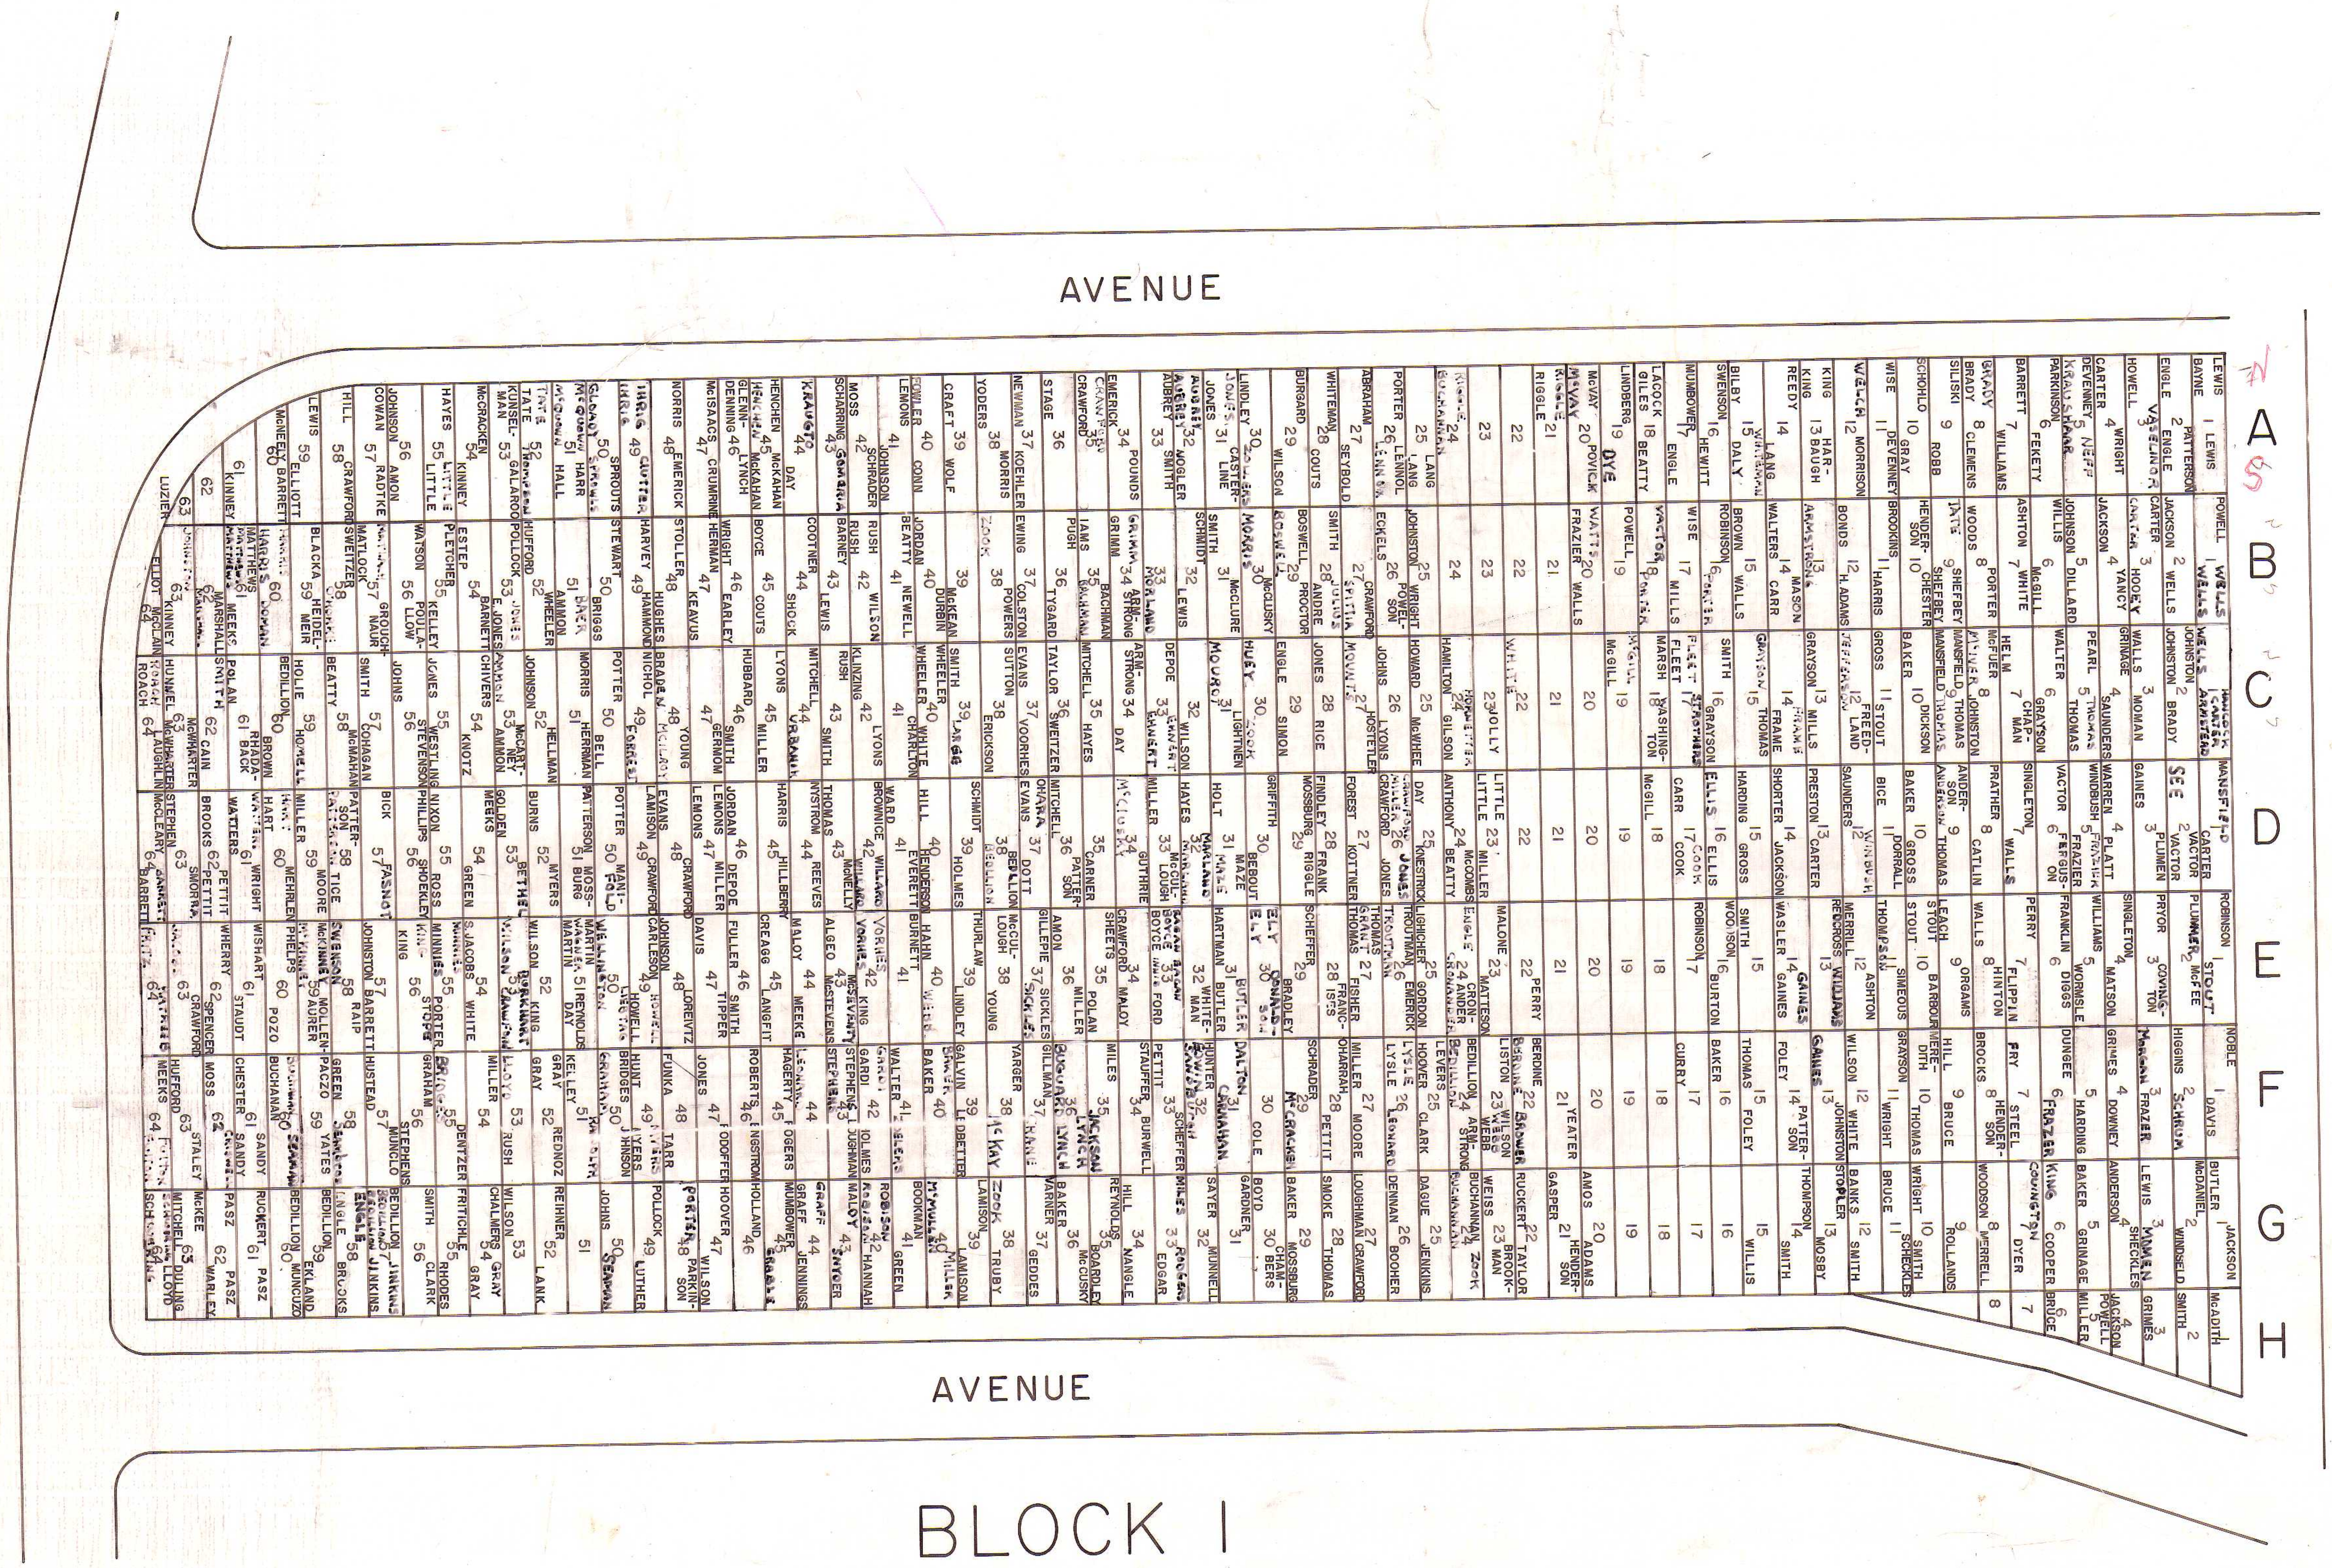

AVENUE
A
B
C
D
E
F
G
H
AVENUE
BLOCK I

AVENUE

A	B	C	D	E	F	G	H	I	J
A. JORDAN 1	KINNAN 1	1 BEBOUT, M.A.	C. BICE 1	M.O. MILLER 1	S.H. WILKINSON 1	WOLFE 1	KING 1	A. ZELLERS 1	BOWEN 1
JORDAN 2	KINNAN 2	W.H. BEBOUT 2	W. ALEXANDER 2	H.M. DENZER 2	F. WILKINSON 2	S.M. WOLFE 2	KING 2	HENDERSON, M.L. 2	C. BOWEN 2
JORDAN 3	N.P. LICJA 3	M. SPENCE 3	E. POLAND 3	J. DENTZER 3	E. VANKIRK 3	S. STANLEY 3	C. ROBERTS 3	S.J. HENDERSON 3	S.B. RINGER 3
4 MITCHELL	MYRTLE MITCHELL 4	A. SPENCE 4	M. DEVENNEY 4	H.W. THOMAS 4	A.L. JONES 4	N.J. THOMPSON 4	O.P. ROBERTS 4	W. REEDY 4	H.E. JOHNSTON 4
5 MILO MITCHELL	MITCHELL 5	A.L. LANDER 5	W. DENTZOR 5	A. McKENNEY 5	E. BURNS 5	G. WARD 5	W. REESE 5	M. SMITH 5	M.L. FULLER 5
N. MOGLER 6 M. FORINGER	E. HANNA 6	G. HUTCHISON 6	MACCHRILOLE 6	E. PHILLIPS 6	N. BURNS 6	A. EWART 6	M. LEWELLYN 6	A.L. SMITH 6	S.H. WADSWORTH 6
7 FORINGER	INFANT-HANNA 7 R. HANNA	J.K. LOWERY 7	E. WONSETTLER 7	S. CAIN 7	E. HERMAN 7	O. EWART 7	R. ANDERSON 7	LITTLE 7 J. LITTLE	A.R. CORNELL 7
8 DUNN	DUNN 8	E.E. LOWREY 8	K. WONSETTLER 8	J. CAIN 8	M. VERNER 8	M.M. WILSON 8	H.G. KING 8	W.P. BERRY 8	H. WICKMAN 8
W. DUNN 9	DUNN 9	LANGFITT 9	O.M. GRAY 9 E.E. GRAY	R. CROSS 9	W.E. LUELLEN 9	WILSON 9	BEATTY 9	P.B. McNEELY 9	A. SERBENICO 9
F. WHEELER 10 S. WHEELER	WHEELER 10	J.E. WARRELL 10	N. PEPLER 10	M.E. HOPKINS 10	L.H. WHITE 10	RICHMOND 10	EVANS 10	W.W. ROSS 10	A. STEPHENS 10
WHEELER 11	R. WILKINSON 11	C. WARRELL 11	PEPLER 11	J. HOPKINS 11	INFANT-HORTON 11 M.J. PORTER	BRADY 11	K.V. McCAMIC 11	E.A. BROWNLEE 11	R. BROWNLEE 11
WHEELER 12	C. WILKINSON 12	McRASTERS 12	WHITLATCH 12	GILES 12	PORTER 12	J.B. CALDWELL 12	L. THARP 12	C.W. BROWNLEE 12	A. BROWNLEE 12
E.A. MORRIS 13	MORRIS 13	H.T. WRIGHT 13	M.J. WHITLATCH 13	P. MOORE 13	M. LANK 13	E.O. GUMP 13	GUMP 13 A. SIMPSON	G.L. GUMP 13	W.H. PECK 13
M.A. MORRIS 14	B. SMITH 14	E. RETTINGER 14	P.O. WHITLATCH 14	E. MOORE 14	H. WOLFE 14	S.J. WOLFE 14	GUMP 14	R. DENTZER 14	H. STERLING 14
P. MORRIS 15	15	I. RETTINGER 15	C. GRAY 15	M. WHEELER 15	G. MYERS 15	C. WILLIAMS 15	H. GUMP 15	J.W. GUMP 15	N. BURKETT 15
D. POLAN 16	MALOY 16	J. KNOX 16	D.L. DICKINSON 16	WISE 16	R.A. DAILEY 16	BURNS 16	SIMPSON 16	GUMP 16 GUMP	E.B. STEPHENS 16
WM. POLAN 17	J.W. DUNN 17	KNOX 17	A.S. ASMAN 17	WISE 17	E. HARTZOG 17	E. BURNS 17	GUMP 17	J.W. GUMP 17 C.E. GUMP	R. DONAHUE 17
B.A. FLETCHER 18 L. FLETCHER	M.J. MARTIN 18	G. BURKE 18	R. HANNA 18	S.E. WISE 18	J. SCHMIDT 18	H.A. MEANS 18	CANAN 18	A. WELSH 18	T.M. PRIMROSE 18
W. FLETCHER 19	W. GRIST 19	J.E. THOMAS 19	19	E. CLARK 19	J. CLEMO 19	WILLIAMS 19	E. NEVILLE 19	H. WISCHMANN 19	J.N. PORTER 19
T. FLETCHER 20	McDANIEL 20	B.M. HEINEY 20	M. KOSO 20	B. SUTTON 20	CASTNER 20	CROOK 20	H.G. KELLEY 20	M. WOODS 20	O. SMITH 20
FLETCHER 21	E.J. WISE 21	M. WHITE 21	R.W. HEINEY 21	A. CZUDEK 21	D.A. WILSON 21	E. RENNER 21	S. TAYLOR 21	M.M. MORRISON 21	J.A. MORGAN 21
JOHN EVANS 22	22	J.E. MILLER 22	E.C. HEINEY 22	H.N. TAYLOR 22 E.J. WISE	SHEARER 22	M. BUCHANAN 22	H.G. RODGERS 22	B. WISCHMANN 22 WISCHMANN	W.G. JOHNSON 22
S.B. McCONNELL 23	E. QUASHNING 23	J. MILLER 23	E.D. HEINEY 23	J.W. BEDILLION 23 J.G. HOLT	B. POWELSON 23	L. PORTER 23	M.E. WALSTROM 23	M.E. RHINEHART 23	P. HENDERSHOT 23
BURK 24	QUASHNING 24	F.I. ZOOK 24	WM. AVERY 24	24	C.E. POWELSON 24	C. HUBBARD 24	R. FILBY 24	S.O. LANDER 24	J. ALEXANDER 24
W.A. BEBOUT 25 READ CRITES HALL	H.A. BEBOUT 25	FLANNAGAN 25	CARROLL 25	NANTEAULT 25	C.B. SMITH 25	A. HEBNER 25	W.E. PHILLIPS 25	B.B. BRESSE 25	C.R. HOUSTON 25 G.F. HOUSTON
L.A. FRAZIER 26	FRAZIER 26	M.S.S. BARROWS 26	I.L. NORRIS 26	WM. DOYLE 26	C. MERCER 26	B. CLARK 26	A. HEBNER 26	H. CANAN 26	M. FLINN 26
WM. FRAZIER 27	FRAZIER 27	H.E. STAUFFER 27	G. NORRIS 27	D. COMPSTON 27	S. VEZEES 27	E. CLARK 27 MARIA CLARK	J. MANDERSON 27	I. HASTING 27	J.W. JOHNSON 27
WM. HUFFMAN 28	HUFFMAN 28	M. REEVES 28	S. LANDERS 28	R. WILLIAMS 28	D.C. CRAFT 28	N.B. FILBY 28	L. RANK 28	CARTER 28	WM. ARMSTRONG 28
C. HUFFMAN 29	HUFFMAN 29	R. REEVES 29	M. ZOOK 29	J. TONEPSKI 29	BAKER 29	SCHAUS 29	W.G. GRATZ 29	S. ZISSIMATOS 29	W.H. POWELL 29
J. HUFFMAN 30	HUFFMAN 30	L. BEDILLION 30	MARRACCINI 30	D.M. ADAMS 30	J.H. BAKER 30	M.P. LINDLEY 30	S.W. VANKIRK 30 T.J. ROWLAND	J. BUICHL 30	E. FISHER 30
ELLIOTT 31	ELLIOTT 31	BEDILLION 31	J. BEATY 31	L. MAZE 31	L. EMERICK 31	W. HOLMES 31	M. GRAFF 31	W.C. CANAN 31	RAYMAN 31
WM. ELLIOTT 32	ELLIOTT 32	M. HISKY 32	LINTEMAN 32	INFANT-MAZE MAZE 32 E. MAZE	O. WILSON 32	A. ADAMS 32	A. HEBNER 32	32	FLANIGAN 32
DUNN 33	DUNN 33	INFANT-KNOX 33 S.A. DOYLE	S.E. COLGRODE 33	M.S. WRIGHT 33	L. AMOS 33	E. GRANDON 33	C. GRATZ 33	M.M. BRIGGS 33	JOHNSON 33
B. DUNN 34	E. OHARRAN 34	E. MARRACCINI 34	INFANT-GREER 34 M. GREER	CALDWELL 34 CALDWELL	A. McCARTY 34	P. WIDINGS 34	B. CONLEY 34	34 RODGERS	C. HALL 34
DUNN 35	DUNN 35	CHAMBERS 35	M.M. BAKER 35	M. KERECHENKO 35	WM. MILLER 35	L.W. DITTRICK 35	H. CONLEY 35	L. BRYSON 35	L. YOUNG 35
VOORHES 36	VOORHES 36	MARRACCINI 36	W.T. BAKER 36 CHARLES BAKER	A. BOLOVAKAS 36	C.D. CRAIG 36	J.S. WHEELER 36	S. HYNDS 36	JONES 36	J.G. PHILLIPS 36
VORHES 37 BARRETT	VOORHES 37	PORTER 37	TENNY 37	37	C. BRATKA 37	H. ARNOLD 37	37	J. MORRISON 37	M. FLUKE 37
HARTON 38 ALICE HARTON	HARTON 38	J.M. TAYLOR 38 G.C. WISE	TENNY 38	H.P. NICHOLS 38	WATSON 38	M.S. CRAWFORD 38	WIVAGG 38	E.L. MURPHY 38	F. HADLEY 38
E. HARTON 39	HARTON 39	PIERCE 39 J.W. PIERCE	TENNY 39	M.A. BELL 39	N. McPEAK 39	W. SNYDER 39	W. SEALS 39	39	J.C. CUNNINGHAM 39
J. PAXTON 40	PAXTON 40	40	TENNY 40	C.F. BUDDEN 40	M. PUGH 40	J. MILLER 40	HARRIETT BELL 40	CROOK 40	G. McKINLEY 40
PAXTON 41	PAXTON 41	A. NOBLE 41	WM. TENNY 41	COUTS 41	R. PARSLEY 41	WM. BARNEDORF 41	BANNER CLARK 41	M. LAMISON 41	G. WINGETT 41
M. CUSHING 42	CUSHING 42	J. NOBLE 42	42	M. MAYAN 42	E.A. SANDERS 42	A. SHUMAKER 42	J.H. MILLER 42	C. PATTERSON 42	M.D. STOWELL 42
M.J. CUSHING 43	J. CUSHING 43	H.J. POUNDS 43	J. POUNDS 43	J. CROY 43	J. HARDIE 43	M.L. PLANTZ 43	GARRETT 43 M. FRYE	SAM ROWE 43 C. ROWE	JIM ROBERTA 43
L.R. CUSHING 44	CUSHING 44	B.L. POUNDS 44	A.L. POUNDS 44	J. DAVIS 44	INFANT-CRISPIN 44 M.A. TURK	T.V. BURGH 44	A. McCONNELL 44	P.H. PETERSON 44	44
DONLEY 45	M.E.D. BRADY 45 DONLEY	M.H. FERRELL 45	C. POUNDS 45	J.H. HUGUS 45	45	P.F. BURGH 45	S. GALVIN 45	MERRY 45	45
R.A. DONLEY 46	B. DONLEY 46	J. HUSTON 46	K. ALLEN 46	BRIGGS 46 E. BRIGGS	M. MILES 46	E. THOMPSON 46	46	L.G. WINSLOW 46	46
KIEHL 47	KIEHL 47	SMITH 47	W. ALLEN 47	B.M. BRIGGS 47	T.I. DAY 47	I.R. ALLEN 47	A. HAMIL 47	C.E. GALVIN 47	
KIEHL 48	KIEHL 48	SMITH 48	L. CRUMRINE 48	F.E. STAHL 48	INFANT-TAYLOR 48 J.N. WISE	J. ALLEN 48	J. HAMIL 48	FLICK 48	
KIEHL 49	KIEHL 49	DAY 49	O.H. GREER 49	VANSICKLE 49	M. MOLLENAUER 49	M.A. LONG 49	S.M. BERRY 49	D. SICKLES 49 R. SICKLES	
WHITLATCH 50	KIEHL 50	G.C. DAY 50	W.H. CAMPBELL 50	J. ENGLE 50	P.F. MOLLENAUER 50 C. MOLLENAUER	H.H. LONG 50	S. BERRY 50		

AVENUE


BLOCK 2


A	B	C	D	E	F	G	H	I	J	
1 WM. T. MATHEWS	J. WILLSON 1	1 S. DANLEY	1 M. AMON	1 L. KING	1 M.E. McELFISH	1 SKARIPA	1 McCUNE	1 ETTA RIGGLE	1 KNESTRICK	1
2 MATHEWS	2 LINDBERG	2 C. FUNKA	2 REED	2 KING	A. McFALL 2	2 F. SANDERQ	2 J.W. McQUOWN	2 S. RIGGLE	2 H.B. CULVER	2
3 E. MATHEWS	3 K. MARTIN	INFANT - MEEKS 3 R.A. REEDY	3 A. WALTER	3 J. ANDIA	3 L. McELFISH	3 R.W. BOARDLEY	3 S. BOARDLEY	3 PUGH	3 A.DICKINSON	3
4 NOACK	4 E. MARTIN	4 I.H. BEBOUT	4 W.C. WALTER, SR.	4 R. MAZZEI	4 G. McMASTERS	4 REISBACK	4 L.E. NYSTROM	4 RANK	4 C.O. WISE	4
5 BARGER	5 P.M. RICHEY	5 J.R. BEBOUT	5 THOMAS	5 E. WEYMER	5 SCHAETER	5 C. REISBACK	5 LEWIS	5 S.G. REEDY	5 M.K. POUNDS	5
6 M. BROOKMAN	6 A.C. McCAULEY	6 M.E. BAKER	6 S.M. THOMAS	6 J. REYNOLDS	SCHAEFFER 6 SCHAEPER	INFANT - SWINGLE 6 G. AYERS	6 E. JOSEPH	6 S. Murray	6 A. DEMOLIN	6
7 L. BROOKMAN	7 N. LAUNCE	RICHMOND 7 RICHMOND	7 C. THOMAS	7 W.E. MAGERS	INFANT-FERNANDES 7 J. FERNANDES	7 P.A. FISHER	7 P.L. CAIN	7 A. RODGERS	7 J. SMITH	7
8 S. ENGLE	8 E. HUNT	8 R. MOSSBURG	8 J.M. DAY	8 S. McCULLEN	8 F. SKILES	8 N.S. FILBY	8 L.E. GOLDEN	8 A. RODGERS	INFANT-ENOCH 8 M.A. ENOCH	8
9 H. HULSKEMP	9 M. KEENER	9 M. McCULLEN	9 J. DAY	9 M.S. SLUSSER	W. RANDOLPH 9 F.L. RANDOLPH	9 A.E. MATTOCK	9 GILBERT	9 E. MARSHALL	9 J. ENOCH	9
10 H. GARRETT	10 WM. JOHNSON	10 W.P. BROOKMAN	10 ROE	10 WM. SLUSSER	10 J. WHITEMAN	10 G.W. STILLWELL	10 M. GILBERT	10 J. MARSHALL	10 N. PIPES	10
11 KING	11 H.F. MADDOX	11 B.M. CARPENTER	11 J.W. KELLY	11 H.F. BEDILLION	11 KERNS	11 E. WARD	INFANT - FISHER 11 D.D. FISHER	11 S. MARSHALL	11 LOVEJOY	11
12 H. GARRETT	12 E. FISHER	12 E.C. MOSSBURG	12 H.M. IRISH	12 C.L. SNOWDON	12 J. KERNS	MORGAN 12 C. MORGAN	INFANT - MAIN 12 MAIN	12 E.E. GORDAN	12 J. McFADDEN	12
L.G. SAGE 13	13 M.S. STAHLE	13 MOUNTS	13 M. ORLOFF	Z. HAUGHT 13	M. PEARSON 13 A.C. PEARSON	13 M. DECICCIO	13 J.R. McCURRY	INFANT - ARNOLD 13 A. ARNOLD	13 J.F. STILES	13
14 F.K. SAGE	14 A. SMITH	14 C. HULSKAMP	14 WM. NICHOLSON	14 P. JANYSECYEK	14 M.M. WELCH	14 WILSON	14 M. BARRETT	14 R. HAMMOND	14 S. FISHER	14
I.M. McCULLOUGH 15 C.W. McCULLOUGH	15 E.J. POLAND	15 HULSKAMP	15 ROSE CHURCH	15 L. HUBOCKER	15 W.W. WARD	15 S.M.R. GALLOWAY	15 S.J. BECK	15 E. WILLIAMS	15 R. MOORE	15
16	16 S.A. POLAND	16 D. CONNOR	16 J.H. CHURCH	INFANT - McCOMBS 16 T.A. McCOMBS	16 S.E. WARD	16 R. ENGLE	16 S.D. HECKMAN	16 C. HECKMAN	16 WISE	16
INFANT - CAREY 17 M. HEWITT	17 H.M. POLAND	L. SEILER 17	17 M.A. MACKEY	17	17 N. WARD	17 J. GREER	17 M. TOLAND	17 M. DECKER	T.J. BILLINGSLEY 17	17
18 W. HEWITT	G. BRIDGE 18 G. SHAFFER	18 H.M. COOK	18 M. COOK	18 M.C. STIENER	18 Poland	18 W.H. STERLING	18 J.H. MILES	18 T. CROWLEY	18 M.D. BILLINGSLEY	18
19 GLEEN	19 VEZIE	M. DIXON 19 T.L. COOK	19 COOK	19 L. SANBURY	19	19 L. MEEKS	19 S. EDWARD	19 WM. McCLUSKEY	19 P. PIKOYANE	19
20 VEZIE	20 S. VEZIE-MANFRED	20 O.M. WATSON	20 R. BUCHANAN	20 J.M. SANBURY	20 J.L. POWERS	20 M.H. BOOHER	20 J.H. MILES	20 B.F. McCLUSKEY	20 M.B. HENDERSON	20
21 G. VEZIE	21 H.A. VEZIE	21 G. DAWSON	21 G.B. GUY	21 J.E. RILEY	21 J. POWERS	21 F. BUCHANAN	21 J. HECKMAN	21 F.V. BOYD	21 E. EMERICK	21
22 S.D. HOLMES	22 VEZIE	22 TOLAND	WM. H. McCOMBS 22 G. GAUGH	22 J.B. DEPOE	22 F.A. GOLDEN	K. McCLAY 22 E. DALE	22 C. ARENT	22 P. ARENT	22 T.A. McCARTNEY	22
23 S. HOLMES	23 VEZIE	23 M. DAWSON	23 E.J. TOLAND	INFANT - DEPOE 23 V.E. DEPOE	23 E. HUFFORD	23 E. McCLAY	23 A. BILLINGS	23	23 LEONARD	23
24 VEZIE	24 VEZIE	24 J. MILSTED	C.A. JONES 24 G.R. JONES	24	24 H.M. MYERS	24 IVERSON	24 S.M. WILMONT	24	24 O. SIMPSON	24
25 A. MOORE	25 R. MOORE	25 V. MILSTED	25 R.W. BLACK	25	25 J. SEAMAN	25 C. LEWELLEN	25 J.G. WILMONT	25 M.A. GILLESPIE	D.W. FORINGER 25 A.M. SIMPSON	25
26 J.J. MOORE	MARKLEY 26 S. GORDON	26 J.W. RITCHEY	26 C. KNESTRICK	26 MOSSBERG	26 J.R. HUFFORD	26 W. IVERSON	26 M. HUFFORD	26 BAKER	26 R.R. HOGE	26
27 S. HARVEY	27	WM. CLUTTER 27 C.R. HUGGINS	27 J.R. MOSSBURG	27 D.L. DANLEY	27 A. KELLERMAN	27 E.C. DALE	27 M. BARNHART	MOUNTS 27 MOUNTS-TOP	27	27
28 E. WILLIAMS	28 M. WILLIAMS	28 W.A. BARNEY	28 M. GLENDENNING	28 E. PERRY	28 H. MORRIS	28 WM. MILES	28 J.C. DALE	28 T.V. KEYS	28 A. DILL	28
S.M.E. WURTZER 29 N. JENNINGS	MARTIN 29 M. PLYMIRE	29	29 M. DICKINSON	29 S.E. BISSETT	29 T. AYERS	29 S. ALLEN	29 J. FRIEND	29 WM. SWAN	29 W. SHOCK	29
A. LENOX 30 J.A. CARLILE	MARSHMAN 30 G. PLYMIRE	30 M.A. ANDERSON	30 M. ANDERSON	30 KNOX	S.J. WEIMER 30	BERKLY 30 BERKBY	30 A. BURWELL	30 J. LOCY	30 G. GOOPER	30
KEENEY 31 KEENEY	31 ISIMINGER	31 A. KELLER	31 J.A. KELLERMAN	31 L. REDDINGER	31 K. SCHMIDT	31 A. BIRKLY	31 M.E. MEEKS	31 J.W. ADAMS	31 A. MOORE	31
32 N.R. CARROLL	32 WILLIAMS	32 S.J. MILLER	32 J.C. PATTERSON	32 M. LANG	32 O. GUMBERT	32 L. IVERSON	32 WM. KNEDMAN	32 A.W. EMERICK	32	32
33 WILLIAMS	33 WILLIAMS	33 M. WELCH	33 J. MITCHELL	33 J.G. LANGE	33 ROBERTS	33	33 S.K. KNEDMAN	33 A. BILLINGS	33 J.W. WILSON	33
34 WILLIAMS	34 WILLIAMS	34 WELSH	34 L. BURNETTE	34 E. JOHNSON	34	34 SEIBERT	34	34 HILTON	34 WINTERS	34
35	35 H.C. LACOCK	35 P. HUTTER	DITTMAN 35 T. DITTMAN	35 LOUIS FOX	35	35 E. YATES	35 C. MILES	35 HILTON	35 C. WAGONER	35
36 L. DEPOE	36 BESSIE MAY	36 S.A. JORDAN	36 R.O. DITTMAN	36 ROSS DEPOE	36	36 H. HUFFORD	36 F. CLIFORD	36 HILTON	36 WAGONER	36
37 M. DEPOE	37 F. DEPOE	37 M. CAMPLE	37 S. STANKOVICH	37 J.E. BARNOTT	37 B. CRAFT	37 J.H. McKERRIHAN	37 I. McKOWEN	SEAMAN 37 A. SEAMAN	37 M.F. PLUMMER	37
38 W.D. DEPOE	38 L. DEPOE	38 T. KISLER	HUTTER 38 HUTTER	38 E. KUNSELMAN	38	38 G. ARTMAN	38	38 A. QUAIC	38 M. PARKINSON	38
39 E. STEPHENS	39 J.L. BAYLES	39 MAITLAND	39 M. COLSTEN	39 L.C. KUNSELMAN	39 M. MANKEY	39	39 C. LAZSLO	39 QUAIL	39	39
40 R. BAYLES	40 S. CALACONDIS	40 A.M. MAITLAND	40 N.E. ARTER	M.A. GOLDEN INFANT 40 W.D. GOLDEN	40 BELL	40	40 N.A. TOMLINSON	40 S. BOYD	40	40
41 O. ZIMERMAN	41 FEASTER	41 C.F. GROH	41 M. WHITE	41 E. JOHNSON	41	41	41 WM. SEATON	41 R. ALLEN	41 S. HENNESBERGER	41
42 L. ZIMERMAN	42 H.J. ZIMERMAN	CRAFT 42 CRAFT	42 T. ROSS	42 A.V. DITTMAN	42 R.B. BAIRD	42	42 M. GOURLY	42 N. LOCY	42 E. KNIGHT	42
43 H. ZIMERMAN	43 ZIMMERMAN	43 J.C. CRAFT	43 G. HUTTER	43 CLARA D. HORN	43 HORN C. HORN	43	43 M. GILBERT	43 W. BILLINGS	43 BURROUGHS	43
NILSEN-SON 44 NICKERSON	44 EVENS	44 SPEASE	44 E. WILLIAMS	44 WALTERHORN	44 S. HORN	44	44	44 E. CUNNINGHAM	44 L. WISE	44
W.W. NICKERSON PATTERSON-SON	NICKERSON 45 4-IN NICKERSON	H.E. LITTLE 45 M.A. LINDBERG	45 M.A. SICKLES	45	45	45	45 BOWSER	45	T. PIATT 45	45
BORRER 46 BORRER	46 H.P. CANON	46 R. REED	46 L. ALLUM	46 A.B. ROUPE	46 J.K. JENKINS	46 E. THOMAS	46 E.M. SWINGLE	INFANT - DALEY 46 N. DALEY	46 N. BANE	46
L. BORROR 47	47	47 L.S. PARSHALL	47 G. CORP	47 HUGHES	47 YANDERS	47 R. SNOWDON	47 S.M. WYATT	47 LOVEJOY	47 N. DAUGHERTY	47
48 E.A. BORROR	48	48	48 T. WILSON	48 L. CALDWELL	48 G. YANDERS	48 LANG	48	48 J. WILLIAMS	48 T. GRAY	48
49 E. BORROR	49 S. COLVERT	49 BURROUGH	49 J.A. BECK	49 W. LINDLEY	49 M. YANDERS	49 F. TIETSWORTH	49 G.C. SUPLER	49 A. HENDERSHOT	49 J.G. BARNHART	49
50 J. BORROR	50	50 BURROUGH	50 M.J. McGREGOR	50 R. LOGAN	50 J. THOMAS	50 J. WARD	50 J.E. KELLY	50 S. MARSHALL	50 B. MARSHALL	50

AVENUE

AVENUE

BLOCK 3

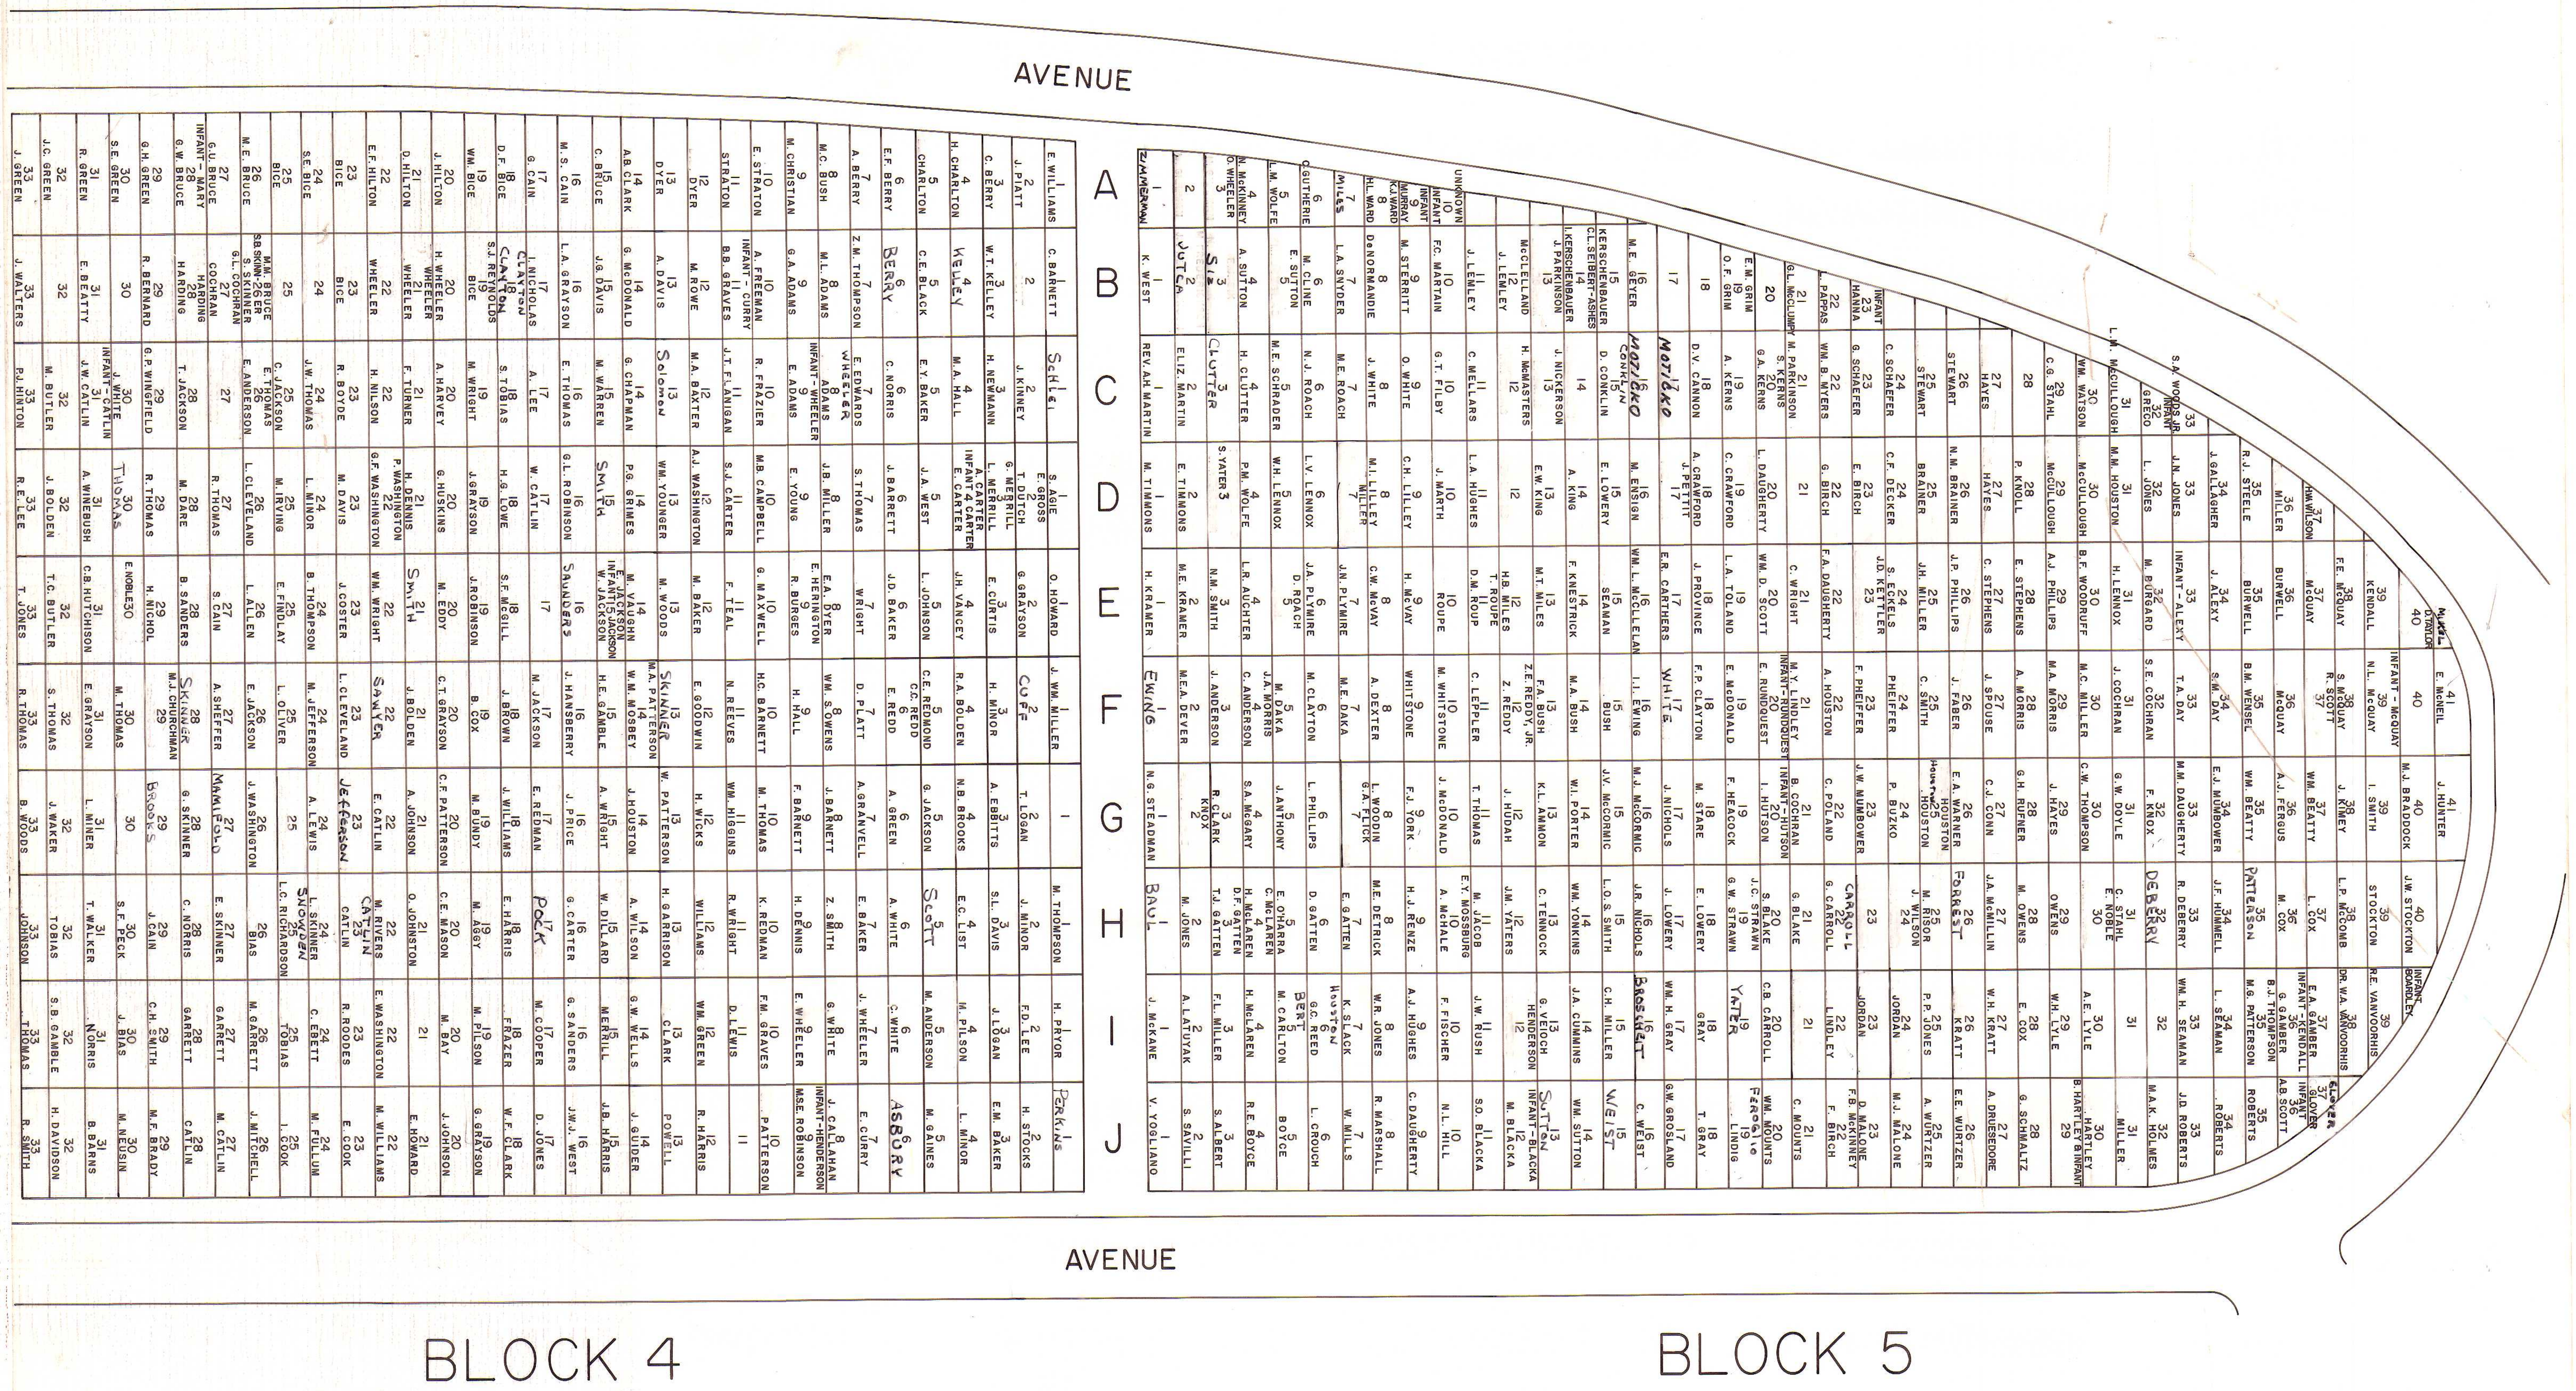
AVENUE
A
B
C
D
E
F
G
H
I
J
AVENUE
BLOCK 4
BLOCK 5

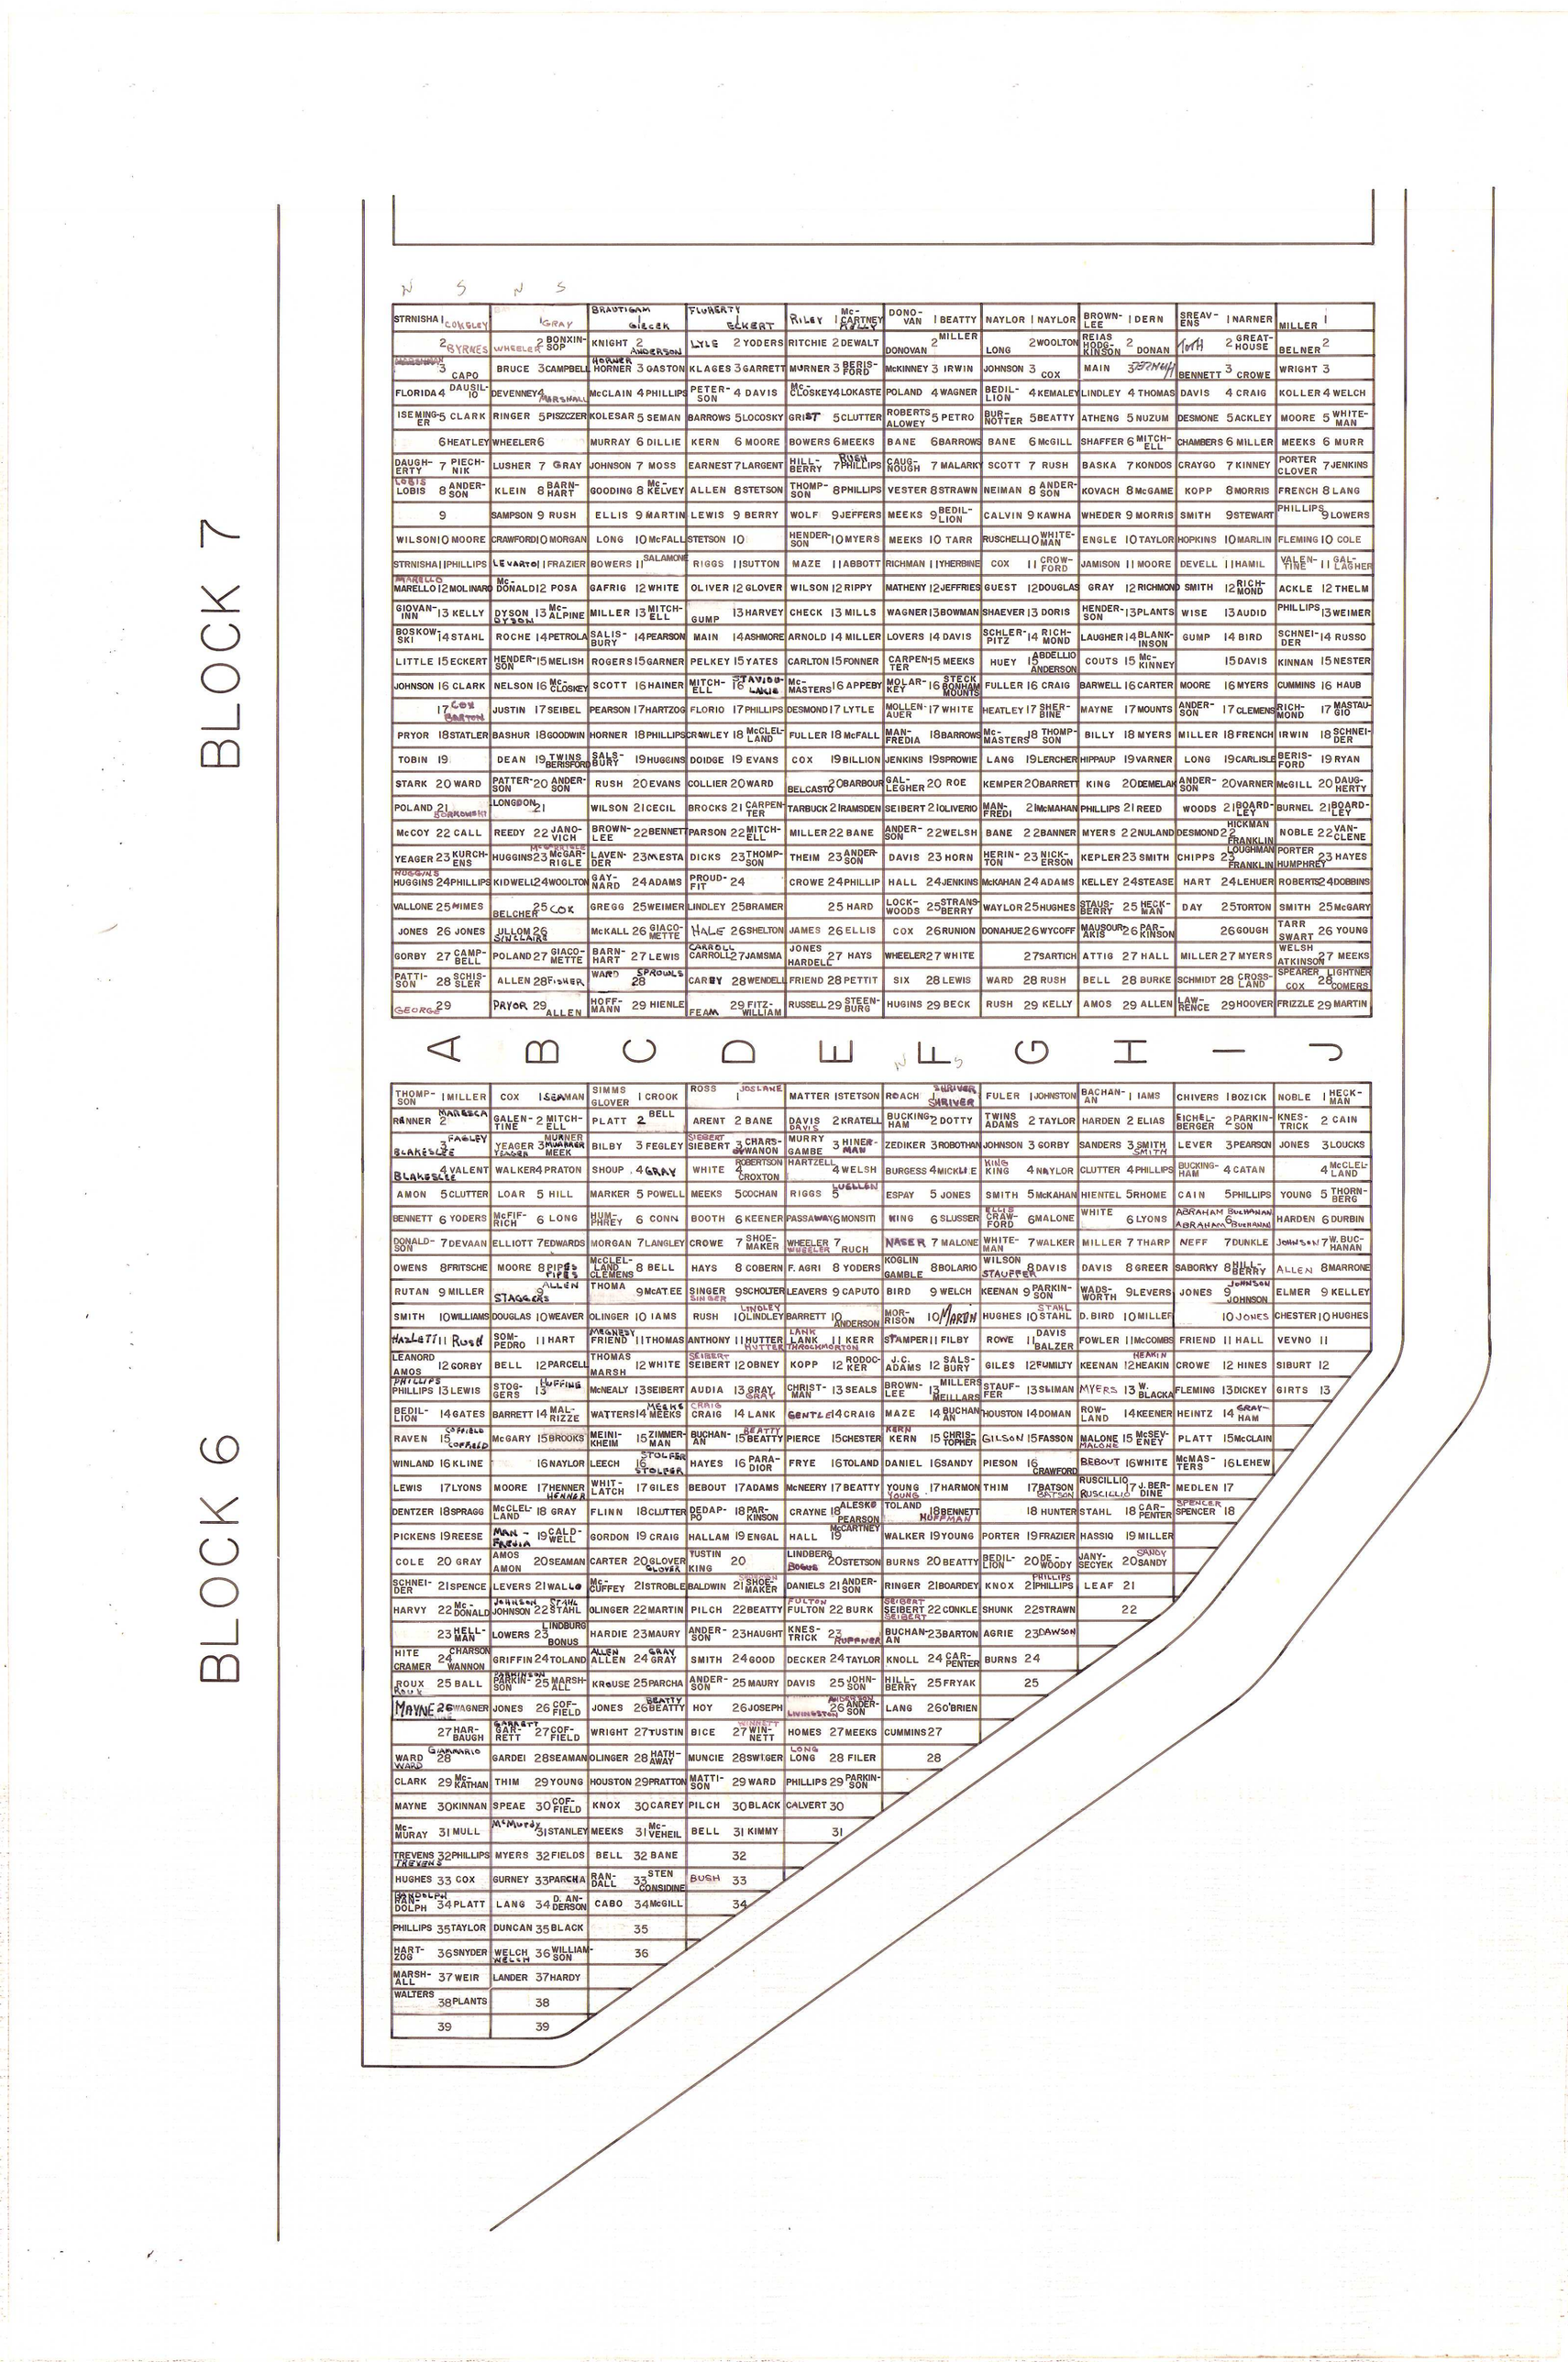

BLOCK 7

BLOCK 6

A B C D E F G H I J

N S N S

A	B	C	D	E	F	G	H	I	J
STRNISHA 1	COKLEY 1 GRAY	BRADTIGAM 1 GLECER	FLOHERTY 1 ECKERT	RILEY 1 McCARTNEY ASTLEY	DONOVAN 1 BEATTY	NAYLOR 1 NAYLOR	BROWN-LEE 1 DERN	SREAVENS 1 NARNER	MILLER 1
2 BYRNES	WHEELER 2 BONXIN-SOP	KNIGHT 2 ANDERSON	LYLE 2 YODERS	RITCHIE 2 DEWALT	DONOVAN 2 MILLER	LONG 2 WOOLTON	REIAS HODG-KINSON 2 DONAN	NORTH 2 GREAT-HOUSE	BELNER 2
3 CAPO	BRUCE 3 CAMPBELL	HORNER 3 GASTON	KLAGES 3 GARRETT	MURNER 3 BERIS-FORD	McKINNEY 3 IRWIN	JOHNSON 3 COX	MAIN 3	BENNETT 3 CROWE	WRIGHT 3
FLORIDA 4 DAUSIL-IO	DEVENNEY 4 MARSHALL	McCLAIN 4 PHILLIPS	PETER-SON 4 DAVIS	Mc-CLOSKEY 4 LOKASTE	POLAND 4 WAGNER	BEDIL-LION 4 KEMALEY	LINDLEY 4 THOMAS	DAVIS 4 CRAIG	KOLLER 4 WELCH
ISEMING-ER 5 CLARK	RINGER 5 PISZCZER	KOLESAR 5 SEMAN	BARROWS 5 LOCOSKY	GRIST 5 CLUTTER	ROBERTS ALOWEY 5 PETRO	BUR-NOTTER 5 BEATTY	ATHENG 5 NUZUM	DESMONE 5 ACKLEY	MOORE 5 WHITE-MAN
6 HEATLEY	WHEELER 6	MURRAY 6 DILLIE	KERN 6 MOORE	BOWERS 6 MEEKS	BANE 6 BARROWS	BANE 6 McGILL	SHAFFER 6 MITCH-ELL	CHAMBERS 6 MILLER	MEEKS 6 MURR
DAUGH-ERTY 7 PIECH-NIK	LUSHER 7 GRAY	JOHNSON 7 MOSS	EARNEST 7 LARGENT	HILL-BERRY 7 RUSH PHILLIPS	CAUG-NOUGH 7 MALARK	SCOTT 7 RUSH	BASKA 7 KONDOS	CRAYGO 7 KINNEY	PORTER CLOVER 7 JENKINS
LOBIS 8 ANDER-SON	KLEIN 8 BARN-HART	GOODING 8 Mc-KELVEY	ALLEN 8 STETSON	THOMP-SON 8 PHILLIPS	VESTER 8 STRAWN	NEIMAN 8 ANDER-SON	KOVACH 8 McGAME	KOPP 8 MORRIS	FRENCH 8 LANG
9	SAMPSON 9 RUSH	ELLIS 9 MARTIN	LEWIS 9 BERRY	WOLF 9 JEFFERS	MEEKS 9 BEDIL-LION	CALVIN 9 KAWHA	WHEDER 9 MORRIS	SMITH 9 STEWART	PHILLIPS 9 LOWERS
WILSON 10 MOORE	CRAWFORD 10 MORGAN	LONG 10 McFALL	STETSON 10	HENDER-SON 10 MYERS	MEEKS 10 TARR	RUSCHELLI 10 WHITE-MAN	ENGLE 10 TAYLOR	HOPKINS 10 MARLIN	FLEMING 10 COLE
STRNISHA 11 PHILLIPS	LEVARTO 11 FRAZIER	BOWERS 11 SALAMONE	RIGGS 11 SUTTON	MAZE 11 ABBOTT	RICHMAN 11 HERBINE	COX 11 CROW-FORD	JAMISON 11 MOORE	DEVELL 11 HAMIL	VALEN-TINE 11 GAL-LAGHER
MARELLO 12 MOLINARO	Mc-DONALD 12 POSA	GAFRIG 12 WHITE	OLIVER 12 GLOVER	WILSON 12 RIPPY	MATHENY 12 JEFFRIES	GUEST 12 DOUGLAS	GRAY 12 RICHMOND	SMITH 12 RICH-MOND	ACKLE 12 THELM
GIOVAN-INN 13 KELLY	DYSON 13 Mc-ALPINE	MILLER 13 MITCH-ELL	GUMP 13 HARVEY	CHECK 13 MILLS	WAGNER 13 BOWMAN	SHAEVER 13 DORIS	HENDER-SON 13 PLANTS	WISE 13 AUDID	PHILLIPS 13 WEIMER
BOSKOW-SKI 14 STAHL	ROCHE 14 PETROLA	SALIS-BURY 14 PEARSON	MAIN 14 ASHMORE	ARNOLD 14 MILLER	LOVERS 14 DAVIS	SCHLER-PITZ 14 RICH-MOND	LAUGHER 14 BLANK-INSON	GUMP 14 BIRD	SCHNEI-DER 14 RUSSO
LITTLE 15 ECKERT	HENDER-SON 15 MELISH	ROGERS 15 GARNER	PELKEY 15 YATES	CARLTON 15 FONNER	CARPEN-TER 15 MEEKS	HUEY 15 ABDELLIO ANDERSON	COUTS 15 Mc-KINNEY	15 DAVIS	KINNAN 15 NESTER
JOHNSON 16 CLARK	NELSON 16 Mc-CLOSKEY	SCOTT 16 HAINER	MITCH-ELL 16 STAVIOS-LAKIS	Mc-MASTERS 16 APPEBY	MOLAR-KEY 16 STECK BONHAM MOUNTS	FULLER 16 CRAIG	BARWELL 16 CARTER	MOORE 16 MYERS	CUMMINS 16 HAUB
17 COX CARTON	JUSTIN 17 SEIBEL	PEARSON 17 HARTZOG	FLORIO 17 PHILLIPS	DESMOND 17 LYTLE	MOLLEN-AUER 17 WHITE	HEATLEY 17 SHER-BINE	MAYNE 17 MOUNTS	ANDER-SON 17 CLEMENS	RICH-MOND 17 MASTAU-GIO
PRYOR 18 STATLER	BASHUR 18 GOODWIN	HORNER 18 PHILLIPS	CROWLEY 18 McCLEL-LAND	FULLER 18 McFALL	MAN-FREDIA 18 BARROWS	Mc-MASTERS 18 THOMP-SON	BILLY 18 MYERS	MILLER 18 FRENCH	IRWIN 18 SCHNEI-DER
TOBIN 19	DEAN 19 TWINS BERISFORD	SALS-BURY 19 HUGGINS	DOIDGE 19 EVANS	COX 19 BILLION	JENKINS 19 SPROWIE	LANG 19 LERCHER	HIPPAUP 19 VARNER	LONG 19 CARLISLE	BERIS-FORD 19 RYAN
STARK 20 WARD	PATTER-SON 20 ANDER-SON	RUSH 20 EVANS	COLLIER 20 WARD	BELCASTO 20 OBARBOUR	GAL-LEGHER 20 ROE	KEMPER 20 BARRETT	KING 20 DEMELAK	ANDER-SON 20 VARNER	McGILL 20 DAUG-HERTY
POLAND 21 BORKOWSKI	LONGDON 21	WILSON 21 CECIL	BROCKS 21 CARPEN-TER	TARBUCK 21 RAMSDEN	SEIBERT 21 OLIVERIO	MAN-FREDI 21 McMAHAN	PHILLIPS 21 REED	WOODS 21 BOARD-LEY	BURNEL 21 BOARD-LEY
McCOY 22 CALL	REEDY 22 JANO-VICH	BROWN-LEE 22 BENNETT	PARSON 22 MITCH-ELL	MILLER 22 BANE	ANDER-SON 22 WELSH	BANE 22 BANNER	MYERS 22 NULAND	DESMOND 22 HICKMAN FRANKLIN	NOBLE 22 VAN-CLENE
YEAGER 23 KURCH-ENS	HUGGINS 23 McGAR-RIGLE	LAVEN-DER 23 MESTA	DICKS 23 THOMP-SON	THEIM 23 ANDER-SON	DAVIS 23 HORN	HERIN-TON 23 NICK-ERSON	KEPLER 23 SMITH	CHIPPS 23 LOUGHMAN FRANKLIN	PORTER 23 HAYES HUMPHREY
HUGGINS 24 PHILLIPS	KIDWELL 24 WOOLTON	GAY-NARD 24 ADAMS	PROUD-FIT 24	CROWE 24 PHILLIP	HALL 24 JENKINS	McKAHAN 24 ADAMS	KELLEY 24 STEASE	HART 24 LEHUER	ROBERTS 24 DOBBINS
VALLONE 25 MIMES	BELCHER 25 COX	GREGG 25 WEIMER	LINDLEY 25 BRAMER	25 HARD	LOCK-WOODS 25 STRANS-BERRY	WAYLOR 25 HUGHES	STAUS-BERRY 25 HECK-MAN	DAY 25 TORTON	SMITH 25 McGARY
JONES 26 JONES	ULLOM 26 SINCLAIR	McKALL 26 GIACO-METTE	HALE 26 SHELTON	JAMES 26 ELLIS	COX 26 RUNION	DONAHUE 26 WYCOFF	MAUSOUR ARIS 26 PAR-KINSON	26 GOUGH	TARR SWART 26 YOUNG
GORBY 27 CAMP-BELL	POLAND 27 GIACO-METTE	BARN-HART 27 LEWIS	CARROLL CARROLL 27 JAMSMA	JONES HARDELE 27 HAYS	WHEELER 27 WHITE	27 SARTICH	ATTIG 27 HALL	MILLER 27 MYERS	WELSH ATKINSON 27 MEEKS
PATTI-SON 28 SCHIS-LER	ALLEN 28 FISHER	WARD 28 SPROWLS	CAREY 28 WENDELL	FRIEND 28 PETTIT	SIX 28 LEWIS	WARD 28 RUSH	BELL 28 BURKE	SCHMIDT 28 CROSS-LAND	SPEARER 28 LIGHTNER COX COMERS
GEORGE 29	PRYOR 29 ALLEN	HOFF-MANN 29 HIENLE	FEAM 29 FITZ-WILLIAM	RUSSELL 29 STEEN-BURG	HUGINS 29 BECK	RUSH 29 KELLY	AMOS 29 ALLEN	LAW-RENCE 29 HOOVER	FRIZZLE 29 MARTIN

A	B	C	D	E	F	G	H	I	J
THOMP-SON 1 MILLER	COX 1 SEAMAN	SIMMS GLOVER 1 CROOK	ROSS 1 JOSLANE	MATTER 1 STETSON	ROACH 1 SHRIVER SHRIVER	FULER 1 JOHNSTON	BACHAN-AN 1 IAMS	CHIVERS 1 BOZICK	NOBLE 1 HECK-MAN
RANNER 2 MARRESCA	GALEN-TINE 2 MITCH-ELL	PLATT 2 BELL	ARENT 2 BANE	DAVIS DAVIS 2 KRATELL	BUCKING-HAM 2 DOTTY	TWINS ADAMS 2 TAYLOR	HARDEN 2 ELIAS	EICHEL-BERGER 2 PARKIN-SON	KNES-TRICK 2 CAIN
BLAKESLEE 3 FAGLEY	YEAGER YEAGER 3 MUMMER MUMMER MEEK	BILBY 3 FEGLEY	SIEBERT SIEBERT 3 CHARS-OWANON	MURRY GAMBE 3 HINER-MAN	ZEDIKER 3 ROBOTHAN	JOHNSON 3 GORBY	SANDERS 3 SMITH SMITH	LEVER 3 PEARSON	JONES 3 LOUCKS
BLAKESLEE 4 VALENT	WALKER 4 PRATON	SHOUP 4 GRAY	WHITE 4 ROBERTSON CROXTON	HARTZELL 4 WELSH	BURGESS 4 MICKLE	KING KING 4 NAYLOR	CLUTTER 4 PHILLIPS	BUCKING-HAM 4 CATAN	4 McCLEL-LAND
AMON 5 CLUTTER	LOAR 5 HILL	MARKER 5 POWELL	MEEKS 5 COCHAN	RIGGS 5 LUELLEN	ESPAY 5 JONES	SMITH 5 McKAHAN	HIENTEL 5 RHOME	CAIN 5 PHILLIPS	YOUNG 5 THORN-BERG
BENNETT 6 YODERS	McFIF-RICH 6 LONG	HUM-PHREY 6 CONN	BOOTH 6 KEENER	PASSAWAY 6 MONSITI	WING 6 SLUSSER	KEITH CRAW-FORD 6 MALONE	WHITE 6 LYONS	ABRAHAM ABRAHAM 6 BOLEMAN BOLEMAN	HARDEN 6 DURBIN
DONALD-SON 7 DEVAAN	ELLIOTT 7 EDWARDS	MORGAN 7 LANGLEY	CROWE 7 SHOE-MAKER	WHEELER WHEELER 7 RUCH	NAGER 7 MALONE	WHITE-MAN 7 WALKER	MILLER 7 THARP	NEFF 7 DUNKLE	JOHNSON 7 W. BUC-HANAN
OWENS 8 FRITSCHE	MOORE 8 PIPES PIPES	McCLEL-LAND CLEMENS 8 BELL	HAYS 8 COBERN	F. AGRI 8 YODERS	KOGLIN GAMBLE 8 OLARIO	WILSON STAUFFER 8 DAVIS	DAVIS 8 GREER	SABORKY 8 HILL-HERRY	ALLEN 8 MARRONE
RUTAN 9 MILLER	STAGGERS 9 ALLEN	THOMA 9 McATEE	SINGER SINGER 9 SCHOLTER	LEAVERS 9 CAPUTO	BIRD 9 WELCH	KEENAN 9 PARKIN-SON	WADS-WORTH 9 LEVERS	JONES 9 JOHNSON JOHNSON	ELMER 9 KELLEY
SMITH 10 WILLIAMS	DOUGLAS 10 WEAVER	OLINGER 10 IAMS	RUSH 10 LINDLEY LINDLEY	BARRETT 10 ANDERSON	MOR-RISON 10 MARTIN	HUGHES 10 STAHL STAHL	D. BIRD 10 MILLER	10 JONES	CHESTER 10 HUGHES
HAZLETT 11 RUSH	SOM-PEDRO 11 HART	MAHONEY FRIEND 11 THOMAS	ANTHONY 11 HUTTER HUTTER THOMPSON	LANK LANK 11 KERR	STAMPER 11 FILBY	ROWE 11 DAVIS BALZER	FOWLER 11 McCOMBS	FRIEND 11 HALL	VEVNO 11
LEANORD AMOS 12 GORBY	BELL 12 PARCELL	THOMAS MARSH 12 WHITE	SEIBERT SEIBERT 12 OBNEY	KOPP 12 RODOC-KER	J.C. ADAMS 12 SALS-BURY	GILES 12 FUMILTY	KEENAN 12 HEAKIN HEAKIN	CROWE 12 HINES	SIBURT 12
PHILLIPS PHILLIPS 13 LEWIS	STOG-GERS 13 LUPPING	McNEALY 13 SEIBERT	AUDIA 13 GRAY GRAY	CHRIST-MAN 13 SEALS	BROWN-LEE 13 MILLERS BEILLARS	STAUF-FER 13 SLIMAN	MYERS 13 W. BLACKA	FLEMING 13 DICKEY	GIRTS 13
BEDIL-LION 14 GATES	BARRETT 14 MAL-RIZZE	WATTERS 14 MEEKS CHRIS MEEKS	CRAIG 14 LANK	GENTLE 14 CRAIG	MAZE 14 BUCHAN AN	HOUSTON 14 DOMAN	ROW-LAND 14 KEENER	HEINTZ 14 GRAY-HAM	
RAVEN 15 SOFRIDE LOOFRIDE	McGARY 15 BROOKS	MEINI-KHEIM 15 ZIMMER-MAN	BUCHAN-AN 15 BEATTY BEATTY	PIERCE 15 CHESTER	KERN KERN 15 CHRIS-TOPHER	GILSON 15 FASSON	MALONE MALONE 15 McSEV-ENEY	PLATT 15 McCLAIN	
WINLAND 16 KLINE	16 NAYLOR	LEECH 16 STOLFER STOLFER	HAYES 16 PARA-DIOR	FRYE 16 TOLAND	DANIEL 16 SANDY	PIESON 16 CRAWFORD	BEBOUT 16 WHITE	McMAS-TERS 16 LEHEW	
LEWIS 17 LYONS	MOORE 17 HENNER HENNER	WHIT-LATCH 17 GILES	BEBOUT 17 ADAMS	McNEERY 17 BEATTY	YOUNG YOUNG 17 HARMON	THIM 17 BATSON BATSON	RUSCILLIO RUSCILLIO 17 J. BER-DINE	MEDLEN 17	
DENTZER 18 SPRAGG	McCLEL-LAND 18 GRAY	FLINN 18 CLUTTER	DEDAP-PO 18 PAR-KINSON	CRAYNE 18 ALESKO PEARSON	TOLAND 18 BENNETT HUFFMAN	18 HUNTER	STAHL 18 CAR-PENTER	SPENCER SPENCER 18	
PICKENS 19 REESE	MAN - FRENA 19 CALD-WELL	GORDON 19 CRAIG	HALLAM 19 ENGAL	HALL 19 MCCARTNEY	WALKER 19 YOUNG	PORTER 19 FRAZIER	HASSIQ 19 MILLER		
COLE 20 GRAY	AMOS AMON 20 SEAMAN	CARTER 20 GLOVER GLOVER	TUSTIN KING 20	LINDBERG BOGUE 20 STETSON	BURNS 20 BEATTY	BEDIL-LION 20 DE-WOODY	JANY-SECYEK SANDY 20 SANDY		
SCHNEI-DER 21 SPENCE	LEVERS 21 WALLO	Mc-CUFFEY 21 STROBLE	BALDWIN 21 SHOE-MAKER	DANIELS 21 ANDER-SON	RINGER 21 BOARDEY	KNOX PHILLIPS 21 PHILLIPS	LEAF 21		
HARVY 22 Mc-DONALD	JOHNSON JOHNSON 22 STAHL	OLINGER 22 MARTIN	PILCH 22 BEATTY	FULTON FULTON 22 BURK	SEIBERT SEIBERT 22 CONKLE	SHUNK 22 STRAWN	22		
23 HELL-MAN	LOWERS 23 LINDBURG BONUS	HARDIE 23 MAURY	ANDER-SON 23 HAUGHT	KNES-TRICK 22 RUPPENER	BUCHAN-AN 23 BARTON	AGRIE 23 DAWSON			
HITE CRAMER 24 CHARSON WANNON	GRIFFIN 24 TOLAND	ALLEN ALLEN 24 GRAY GRAY	SMITH 24 GOOD	DECKER 24 TAYLOR	KNOLL 24 CAR-PENTER	BURNS 24			
ROUX ROUX 25 BALL	PARRINEN PARKIN-SON 25 MARSH-ALL	KROUSE 25 PARCHA	ANDER-SON 25 MAURY	DAVIS 25 JOHN-SON	HILL-BERRY 25 FRYAK	25			
MAYNE MAYNE 26 WAGNER	JONES 26 COF-FIELD	JONES BEATTY 26 BEATTY	HOY 26 JOSEPH	LIVINGSTON ANDERSON 26 ANDER-SON	LANG 26 O'BRIEN				
27 HAR-BAUGH	GARRETT BAR-RETT 27 COF-FIELD	WRIGHT 27 TUSTIN	BICE 27 WIN-NETT	HOMES 27 MEEKS	CUMMINS 27				
WARD WARD GIAMMARIO 28	GARDEI 28 SEAMAN	OLINGER 28 HATH-AWAY	MUNCIE 28 SWIGER	LONG LONG 28 FILER	28				
CLARK 29 Mc-KATHAN	THIM 29 YOUNG	HOUSTON 29 PRATTON	MATTI-SON 29 WARD	PHILLIPS 29 PARKIN-SON					
MAYNE 30 KINNAN	SPEAE 30 COF-FIELD	KNOX 30 CAREY	PILCH 30 BLACK	CALVERT 30					
Mc-MURAY 31 MULL	McMURDY 31 STANLEY	MEEKS 31 Mc-VEHEIL	BELL 31 KIMMY	31					
TREVENS TREVENS 32 PHILLIPS	MYERS 32 FIELDS	BELL 32 BANE	32						
HUGHES 33 COX	GURNEY 33 PARCHA	RAN-DALL 33 STEN CONSIDINE	BUSH 33						
RANDOLPH RAN-DOLPH 34 PLATT	LANG 34 D. AN-DERSON	CABO 34 McGILL	34						
PHILLIPS 35 TAYLOR	DUNCAN 35 BLACK	35							
HART-ZOG 36 SNYDER	WELCH WELCH 36 WILLIAM-SON	36							
MARSH-ALL 37 WEIR	LANDER 37 HARDY								
WALTERS 38 PLANTS	38								
39	39								

BLOCK 8


VETERAN'S SECTION

	A	B	C	D	E	F	G	H	I	J
1	FILBY	KERON	KENNEDY	ROBISON						
2	JOHNSON	HAMMOND	LEWIS	PATTERSON	KORN					
3	HOLMES	SHRIVER	O'BRIEN	HAUGHT						
4	IRELAND	WILLIAMSON	MOYER	EVANS	POSTLETHWAITE					
5	WATSON	ADAMS	BOYD	WELCH						
6	FITTS	PETTIT	CHARMLEY	BURNETTE	KNOX JR					
7	EVANS	MCCARTNEY	CHICONE	CROSBY						
8	CARNEY	MOUSARAKIS	BRYSINGER	MILLER	LANE					
9	LUCAS	WELSH	ASHMORE	LEWIS						
10	HARTZOG	BARBOUR	MCDANIEL	WILLIAMS	PETROLA					
11	AMOS	JALOWKA	LILLARD	HAVENER		TRESSLER				
12	GRIMM	VASKO	DOHERTY	DOHERTY	COX					
13	BOWYER	MORRELL	BERGER	CRABELL	FISHER					
14	DILLARD	NICHOLLS	MORRIS	PHILLIPS	AUGENSTEIN					
15	HELIZKE	POLLARD	GORDON	FORLETT	MCNAMARA					
16	FLEET	MCCLAIN	NARUS	POLLARD	CARPENTER					
17	MARSHMAN	OBRIEN	MARSHMAN	NELSON	DELONG					
18	TOMPKINS	OLESKI	HEIM	BOOKER	DINARDO					
19	PEMBERTON	GWYNN	JACOBS	ROBERTS BOOKER	MCKINNEY					
20	TIBERI	WARD	PROVINS	CLUTTER	MOORE					
21										
22										
23										
24										

	K	L	M	N	O	P	Q	R	S	T
1	M. WELLS	HILL	D. MAUREA	W. RUTLEDGE	N. WASHINGTON		L. MADISON	M. WRIGHT	F.G. AIDS	S. GAINES
2	S. BUTTLER	HILL	P. SEE	N. CARPER	W. WASHINGTON		W. MADISON	A. DEFROSS	H.G. RATSON	
3	W. JOHNSON	W. FRAZIER	M. BURGESS	A. RIDEOUT	R. SIMPSON	A. LEWIS M. LEWIS	E. MANKS C. SHEPPEY			W. BURNS
4	S. MCGILL	L. BEARD	BURGESS N. RIDEOUT		F. BROWN	M. LEWIS	H. HENDERSON	J. BURNETTE	M.E. ADAMS THOMAS	T. HILL
5			E. OLAKER	J. PILSON	S. BROOKINS	J. ROBISON	I. WORMSLEY	N. REED	C. WILLIAMS	J. BANKS
6	O. MCCLOUD	F. WELLS	W. THOMPSON	R. GLESSNER	G. DERRY M. PRICE		C. HOLIBURTON	L. JOHNSON	P. CATLIN	J.E. AGEY
7	J. BUCHANNON	M. WILLIAMS	J. DERRY	W. POWELL		N. RICHARDSON	M. REDMONT	A. STOUGHT	A. WEBB	G. SPITLER
8	E. OWENS	H. JEFFERSON	C. BROWN	C. DICKERSON	P. SMITH		E. SHORTERS	F. WORMSLEY	M. GREYSBY R. JOHNSTON	G. DAVIS
9	S. AGIE J. WILLIAMS	E. FERRELL	E. BUTLER	I. CARTER	A. HERNDON		E. WATTS A. WARREN	L. CHURCHMAN	S. ELLIS	R. JACKSON
10	H. DENT	R.A. ANDERSON	S.T. OLIVER	J. HARRISON	M. EBBITT	F. MALONE	E. POTTER	N. HOLLE	M. MASON	L. CHURCHMAN
11	S. MINNES	G. SIMPSON	R. SNOWDEN		L. FORD	M. JONES	J. HUGHES	F. HARRIS	M. GARNER W. KEAN	T. BURK
12	R. THOMPSON	C. KENNEDY	J. SMITH	A. REDD	S. BOLDEN	J. BAKER	H. CHRISTIAN	W. JOHNSON	J. BUTTLER	M. HILL JOHNSON
13	A. MCFEE	F. WASHINGTON	H. SMITH	R. ROBISON	B. CARPENTER	A. BAKER BAKER	M. JACKSON	J. WARREN	HENDERSON	L. CHRISTIAN
14	M. WRIGHT	H. SHORTERS	H. BROWN	A. THOMPSON	J. MALONE	W. PLATT	L. PRISBY	E. HARDING	S. HENDERSON	L. MCFEE
15	G. JACKSON	W. GRAYSON	M. BROWN	15	A. WHITE	A. THOMAS	C. WILLIS	B. ANDERSON M. JACKSON V. JACKSON	A. FRAMER	J. CALDWELL
16	J. MCGILL	A. LEWIS	S. THOMAS	J. RAMSEY	M. RAMSEY	R. THOMAS	S. JOHNSON	H. DAVIS	B. WHEELER	W. SMITH
17	H. WELLS	L. FRANKLIN	THOMAS	E. MCDONALD	J. FIELDS	R. ADAMS	J. JACKSON	R. MCDONALD	M. WILLIAMSON	J. DAVIS
18	H. WILLIAMS	E. HARRIS	C. DAVIS L. DAVIS	L. BUTTLER	J. WASHINGTON	A. WEBB		R. PURDY	BLOCKMAN	E. SMITH
19	F. BUNDY	M. LOGAN	A. LEE	E. CORBIN	M. SIMPSON	E. JONES	R. MINOR	S. MCGILL	R. SMITH	M. BAKER
20	M. CLOUTON	T. ALEXANDER	J. FINNEY	N. TURNER	G. WASHINGTON	W. THOMPSON	F. WRIGHT	M. HILL W. HILL	L. RIDEOUT	A. SANDERS
21	R. RITCHARDSON	M. CALHORN	M. THOMAS	L. BOND	J. JOHNSTON	M. WILLIAMS	J. ESSEX	B. JACKSON	G. DOWNEY	W. PORTER
22	A. WEST	W. BROWN	C. HUNTER	M. WORMSLEY	M. COSTLER	W. DAVIS	A. COOPER	C. BROWN	A. WORMSLEY	C. WRIGHT
23	E. JOHNSON	J. LEE	R. STAPLES	E. DAVIS	E. CATLIN	J. JONES	W. LIDDELL	L. ESSEX	E. DAVIS I. WILLIAMS	WM. WATTS
24	J. JOHNSON	E. MCDONALD	L. CALDWELL	24	I. DEMPSTER	E. BLACK	E. SNYDER	M. BROWN	E. CAUL 24 ALEE H. DILLARD	C. SMITH
25	A. PRISBY	J. EDWARDS	W. WILLIAMS	I. GAMBALL	S. HATCHER	H. BOLDIN	A. STRIEBLING	J. PATES	25	J. DAVIS
26	P. MITCHELL	L. DIXON M. DIXON	M. CURRY	H. TURNER	26	G. BROWN	C. HEBBROW	K. MCGONALD	M. FRANKLIN	O. WOODSON WOODSON & WOODSON INFANT - WOODSON
27	S. SMITH	W. RUMER	S. WILLIAMS	L. FREEMAN	27	27	W. MORGAN M. SMITH	N. FRAME	I. WILLIAMS	S. SHORTERS
28	I. SHORTERS	A. BROWN	A. ASBURY	E. WHEELER	B. GOLDEN	A. SMITH	H. HENDERSON	P. CARTER	L. JOHNSON	C. CATLIN
29	J. FRAME	L. GREEN	H. STEWART	W. BOLDEN	E. BALDWIN	R. JACKSON	E. GODFERY	L. FITTS	R. KING	J. TAYLOR THORNTON
30	S. HATCHER	S. WELLS	E. HOUSE	M. JOHNSON	D. EDWARDS	W. WELLS	L. JOHNSON	H. DYER	W. ANDERSON	F. REEVES
31	W. RUMOTES	A. HOUSE	J. DAVIS	31	E. COOPER	A. WHITE	31	J. CAMPBELL	A. CATLIN	R. PATTERSON
32	F. WINEGARNER	N. JORDAN	J. WORMSLEY	R. COOPER	H. MILLER	H. COX	G. HENDERSON	M. FRAZICK	A. THOMPSON	S. PRESTON
33	W. JOHNSON	E. JORDAN	L.B. ANDERSON	C. COOPER	T. BLACK	M. PARSON	M. BAKER	33 CURRY	L. JOHNSON	A. LIST

BLOCK 9


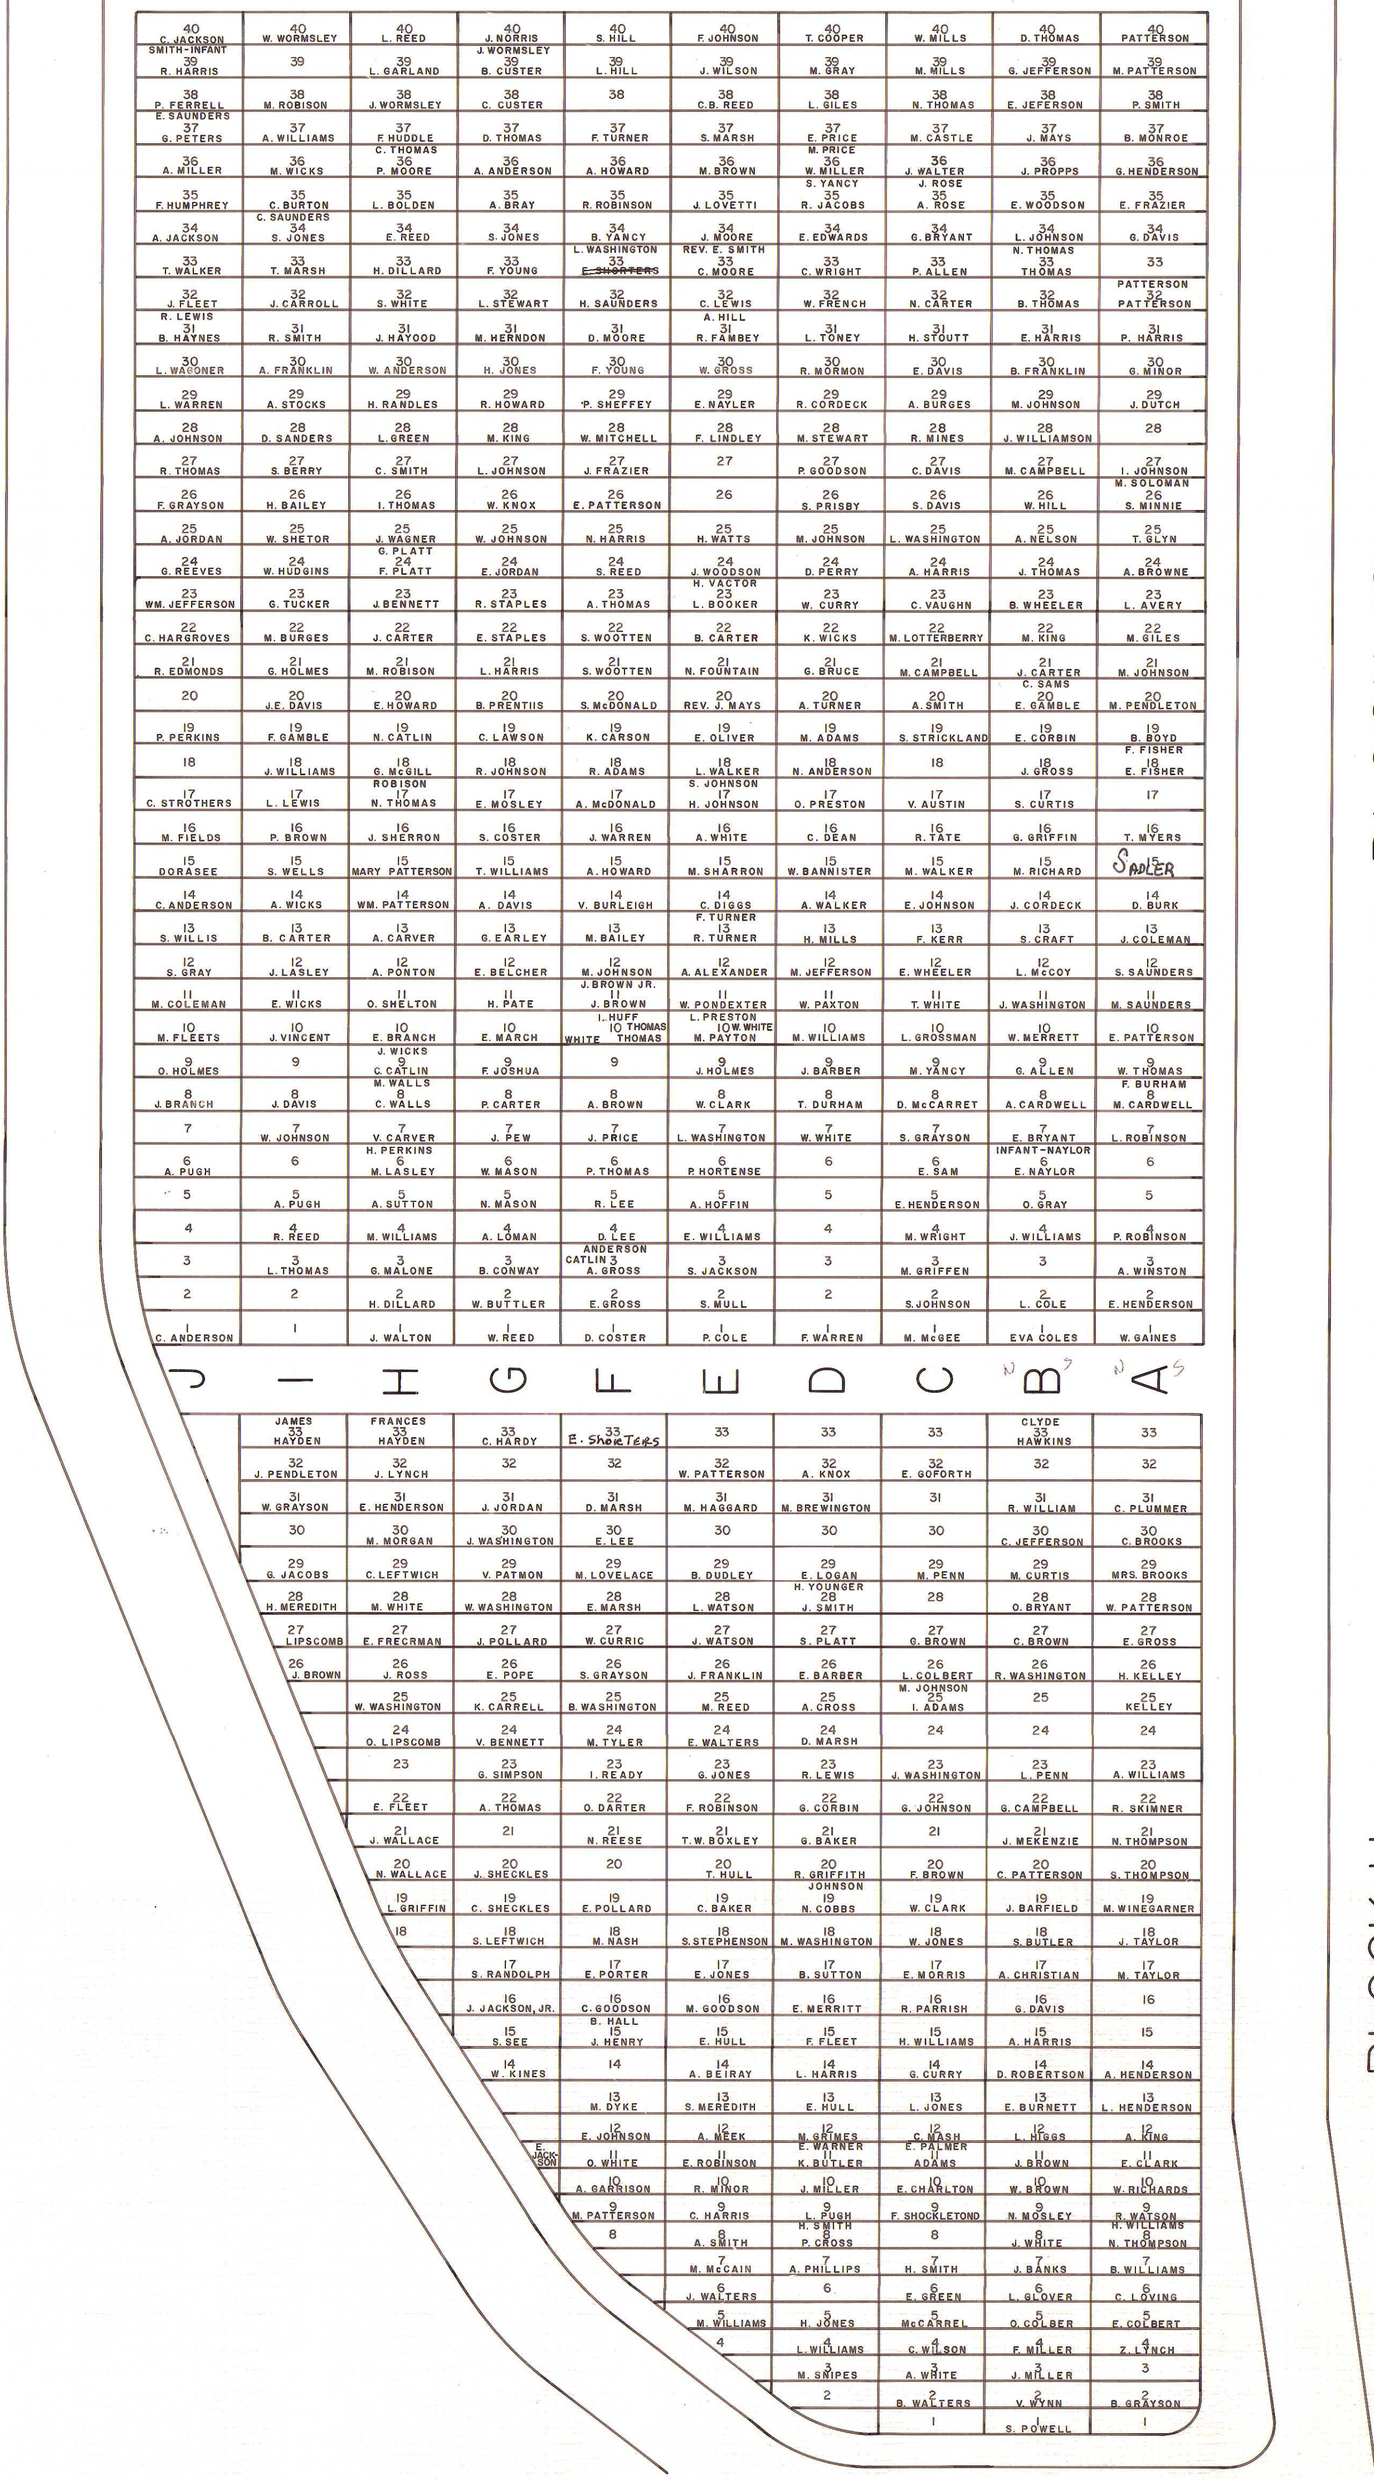
BLOCK 10
BLOCK 11
J
I
H
G
F
E
D
C
B
A
C. JACKSON
W. WORMSLEY
L. REED
J. NORRIS
S. HILL
F. JOHNSON
T. COOPER
W. MILLS
D. THOMAS
PATTERSON
SMITH-INFANT
R. HARRIS
L. GARLAND
J. WORMSLEY
B. CUSTER
L. HILL
J. WILSON
M. GRAY
M. MILLS
G. JEFFERSON
M. PATTERSON
P. FERRELL
M. ROBISON
J. WORMSLEY
C. CUSTER
C.B. REED
L. GILES
N. THOMAS
E. JEFERSON
P. SMITH
E. SAUNDERS
G. PETERS
A. WILLIAMS
F. HUDDLE
D. THOMAS
F. TURNER
S. MARSH
E. PRICE
M. CASTLE
J. MAYS
B. MONROE
C. THOMAS
A. MILLER
M. WICKS
P. MOORE
A. ANDERSON
A. HOWARD
M. BROWN
M. PRICE
W. MILLER
J. WALTER
J. PROPPS
G. HENDERSON
S. YANCY
F. HUMPHREY
C. BURTON
L. BOLDEN
A. BRAY
R. ROBINSON
J. LOVETTI
R. JACOBS
J. ROSE
A. ROSE
E. WOODSON
E. FRAZIER
C. SAUNDERS
A. JACKSON
S. JONES
E. REED
S. JONES
B. YANCY
J. MOORE
E. EDWARDS
G. BRYANT
L. JOHNSON
G. DAVIS
L. WASHINGTON
REV. E. SMITH
N. THOMAS
T. WALKER
T. MARSH
H. DILLARD
F. YOUNG
E. SHORTERS
C. MOORE
C. WRIGHT
P. ALLEN
THOMAS
PATTERSON
J. FLEET
J. CARROLL
S. WHITE
L. STEWART
H. SAUNDERS
C. LEWIS
W. FRENCH
N. CARTER
B. THOMAS
PATTERSON
R. LEWIS
B. HAYNES
R. SMITH
J. HAYOOD
M. HERNDON
D. MOORE
A. HILL
R. FAMBEY
L. TONEY
H. STOUTT
E. HARRIS
P. HARRIS
L. WAGONER
A. FRANKLIN
W. ANDERSON
H. JONES
F. YOUNG
W. GROSS
R. MORMON
E. DAVIS
B. FRANKLIN
G. MINOR
L. WARREN
A. STOCKS
H. RANDLES
R. HOWARD
P. SHEFFEY
E. NAYLER
R. CORDECK
A. BURGES
M. JOHNSON
J. DUTCH
A. JOHNSON
D. SANDERS
L. GREEN
M. KING
W. MITCHELL
F. LINDLEY
M. STEWART
R. MINES
J. WILLIAMSON
R. THOMAS
S. BERRY
C. SMITH
L. JOHNSON
J. FRAZIER
P. GOODSON
C. DAVIS
M. CAMPBELL
I. JOHNSON
M. SOLOMAN
F. GRAYSON
H. BAILEY
I. THOMAS
W. KNOX
E. PATTERSON
S. PRISBY
S. DAVIS
W. HILL
S. MINNIE
A. JORDAN
W. SHETOR
J. WAGNER
H. WATTS
M. JOHNSON
L. WASHINGTON
A. NELSON
T. GLYN
G. PLATT
G. REEVES
W. HUDGINS
F. PLATT
E. JORDAN
S. REED
J. WOODSON
D. PERRY
A. HARRIS
J. THOMAS
A. BROWNE
H. VACTOR
WM. JEFFERSON
G. TUCKER
J. BENNETT
R. STAPLES
A. THOMAS
L. BOOKER
W. CURRY
C. VAUGHN
B. WHEELER
L. AVERY
C. HARGROVES
M. BURGES
J. CARTER
E. STAPLES
S. WOOTTEN
B. CARTER
K. WICKS
M. LOTTERBERRY
M. KING
M. GILES
R. EDMONDS
G. HOLMES
M. ROBISON
L. HARRIS
S. WOOTTEN
N. FOUNTAIN
G. BRUCE
M. CAMPBELL
J. CARTER
M. JOHNSON
C. SAMS
J.E. DAVIS
E. HOWARD
B. PRENTIIS
S. McDONALD
REV. J. MAYS
A. TURNER
A. SMITH
E. GAMBLE
M. PENDLETON
P. PERKINS
F. GAMBLE
N. CATLIN
C. LAWSON
K. CARSON
E. OLIVER
M. ADAMS
S. STRICKLAND
E. CORBIN
B. BOYD
F. FISHER
J. WILLIAMS
G. McGILL
R. JOHNSON
R. ADAMS
L. WALKER
N. ANDERSON
J. GROSS
E. FISHER
ROBISON
S. JOHNSON
C. STROTHERS
L. LEWIS
N. THOMAS
E. MOSLEY
A. McDONALD
H. JOHNSON
O. PRESTON
V. AUSTIN
S. CURTIS
M. FIELDS
P. BROWN
J. SHERRON
S. COSTER
J. WARREN
A. WHITE
C. DEAN
R. TATE
G. GRIFFIN
T. MYERS
DORASEE
S. WELLS
MARY PATTERSON
T. WILLIAMS
A. HOWARD
M. SHARRON
W. BANNISTER
M. WALKER
M. RICHARD
SADLER
C. ANDERSON
A. WICKS
WM. PATTERSON
A. DAVIS
V. BURLEIGH
C. DIGGS
A. WALKER
E. JOHNSON
J. CORDECK
D. BURK
F. TURNER
S. WILLIS
B. CARTER
A. CARVER
G. EARLEY
M. BAILEY
R. TURNER
H. MILLS
F. KERR
S. CRAFT
J. COLEMAN
S. GRAY
J. LASLEY
A. PONTON
E. BELCHER
M. JOHNSON
A. ALEXANDER
M. JEFFERSON
E. WHEELER
L. McCOY
S. SAUNDERS
J. BROWN JR.
M. COLEMAN
E. WICKS
O. SHELTON
H. PATE
J. BROWN
W. PONDEXTER
W. PAXTON
T. WHITE
J. WASHINGTON
M. SAUNDERS
I. HUFF
L. PRESTON
M. FLEETS
J. VINCENT
E. BRANCH
E. MARCH
IOW. WHITE
M. PAYTON
M. WILLIAMS
L. GROSSMAN
W. MERRETT
E. PATTERSON
WHITE
THOMAS
J. WICKS
O. HOLMES
C. CATLIN
F. JOSHUA
J. HOLMES
J. BARBER
M. YANCY
G. ALLEN
W. THOMAS
M. WALLS
F. BURHAM
J. BRANCH
J. DAVIS
C. WALLS
P. CARTER
A. BROWN
W. CLARK
T. DURHAM
D. McCARRET
A. CARDWELL
M. CARDWELL
W. JOHNSON
V. CARVER
J. PEW
J. PRICE
L. WASHINGTON
W. WHITE
S. GRAYSON
E. BRYANT
L. ROBINSON
H. PERKINS
INFANT-NAYLOR
A. PUGH
M. LASLEY
W. MASON
P. THOMAS
P. HORTENSE
E. SAM
E. NAYLOR
A. PUGH
A. SUTTON
N. MASON
R. LEE
A. HOFFIN
E. HENDERSON
O. GRAY
R. REED
M. WILLIAMS
A. LOMAN
D. LEE
E. WILLIAMS
M. WRIGHT
J. WILLIAMS
P. ROBINSON
ANDERSON
CATLIN
M. GROSS
L. MALONE
B. CONWAY
S. JACKSON
M. GRIFFEN
A. WINSTON
H. DILLARD
W. BUTTLER
E. GROSS
S. MULL
S. JOHNSON
L. COLE
E. HENDERSON
C. ANDERSON
J. WALTON
W. REED
D. COSTER
P. COLE
F. WARREN
M. McGEE
EVA COLES
W. GAINES
JAMES
HAYDEN
FRANCES
HAYDEN
C. HARDY
E. SHORTERS
CLYDE
HAWKINS
J. PENDLETON
J. LYNCH
W. PATTERSON
A. KNOX
E. GOFORTH
R. WILLIAM
W. GRAYSON
E. HENDERSON
J. JORDAN
D. MARSH
M. HAGGARD
M. BREWINGTON
C. PLUMMER
M. MORGAN
J. WASHINGTON
E. LEE
C. JEFFERSON
C. BROOKS
G. JACOBS
C. LEFTWICH
V. PATMON
M. LOVELACE
B. DUDLEY
E. LOGAN
M. PENN
M. CURTIS
MRS. BROOKS
H. YOUNGER
H. MEREDITH
M. WHITE
W. WASHINGTON
E. MARSH
L. WATSON
J. SMITH
O. BRYANT
W. PATTERSON
LIPSCOMB
E. FRECRMAN
J. POLLARD
W. CURRIC
J. WATSON
S. PLATT
G. BROWN
C. BROWN
E. GROSS
J. BROWN
J. ROSS
E. POPE
S. GRAYSON
J. FRANKLIN
E. BARBER
L. COLBERT
R. WASHINGTON
H. KELLEY
M. JOHNSON
W. WASHINGTON
K. CARRELL
B. WASHINGTON
M. REED
A. CROSS
I. ADAMS
KELLEY
O. LIPSCOMB
V. BENNETT
M. TYLER
E. WALTERS
D. MARSH
G. SIMPSON
I. READY
G. JONES
R. LEWIS
J. WASHINGTON
L. PENN
A. WILLIAMS
E. FLEET
A. THOMAS
O. DARTER
F. ROBINSON
G. CORBIN
G. JOHNSON
G. CAMPBELL
R. SKIMNER
J. WALLACE
N. REESE
T.W. BOXLEY
G. BAKER
J. MEKENZIE
N. THOMPSON
N. WALLACE
J. SHECKLES
T. HULL
R. GRIFFITH
F. BROWN
C. PATTERSON
S. THOMPSON
JOHNSON
L. GRIFFIN
C. SHECKLES
E. POLLARD
C. BAKER
N. COBBS
W. CLARK
J. BARFIELD
M. WINEGARNER
S. LEFTWICH
M. NASH
S. STEPHENSON
M. WASHINGTON
W. JONES
S. BUTLER
J. TAYLOR
S. RANDOLPH
E. PORTER
E. JONES
B. SUTTON
E. MORRIS
A. CHRISTIAN
M. TAYLOR
J. JACKSON, JR.
C. GOODSON
M. GOODSON
E. MERRITT
R. PARRISH
G. DAVIS
B. HALL
S. SEE
J. HENRY
E. HULL
F. FLEET
H. WILLIAMS
A. HARRIS
W. KINES
A. BEIRAY
L. HARRIS
G. CURRY
D. ROBERTSON
A. HENDERSON
M. DYKE
S. MEREDITH
E. HULL
L. JONES
E. BURNETT
L. HENDERSON
E. JOHNSON
A. MEEK
M. STINES
C. MASH
L. HIGGS
A. KING
E. JACKSON
E. WARNER
E. PALMER
O. WHITE
E. ROBINSON
K. BUTLER
ADAMS
J. BROWN
E. CLARK
A. GARRISON
R. MINOR
J. MILLER
E. CHARLTON
W. BROWN
W. RICHARDS
M. PATTERSON
C. HARRIS
L. FUGH
F. SHOCKLETOND
N. MOSLEY
R. WATSON
H. SMITH
H. WILLIAMS
A. SMITH
P. CROSS
J. WHITE
N. THOMPSON
M. McCAIN
A. PHILLIPS
H. SMITH
J. BANKS
B. WILLIAMS
J. WALTERS
E. GREEN
L. GLOVER
C. LOVING
M. WILLIAMS
H. JONES
McCARREL
O. COLBER
E. COLBERT
L. WILLIAMS
C. WILSON
F. MILLER
Z. LYNCH
M. SNIPES
A. WHITE
J. MILLER
B. WALTERS
V. WYNN
B. GRAYSON
S. POWELL

BLOCK 12



A B C D E F G H I J K L M N O P Q
59 ROBINSON, 58 McKENSIE, 57 GIBSON, 56 YADEN, 55 BARFIELD, 54 BROWN, 53 ADAMS, 52 MORRIS, 51 BARRETT, 50 JACKSON, 49 GRAY, 48 BROWN, 47 GRIFFIN, 46 PORTER, 45 VACTOR, 44 PORTER, 43 MIX, 42 WADE, 41 MOSLEY, 40 JOHNSON, 39 ANDERSON, 38 RANSAW, 37 WHITE, 36 MORRELL, 35 TINSLEY, 34 HAIRSTON, 33 ANDERSON, 32 ADAMS, 31 PATTERSON, 30 CROSON, 29 GRUBBS, 28 COLBERT, 27 HALL, 26 WILLIAMS, 25 GILES, 24 SETLINGTON, 23 WATKINS, 22 BRUCE, 21 RHODES, 20 BROWN, 19 MORMAN, 18 BURGESS, 17 WASHINGTON, 16 SMALL, 15 ALFRED SWINGLE
59 HOYLE, 58 HAMILTON, 57 DELL, 56 MINNIE, 55 DERRY, 54 WEBER, 53 REEVES, 52 MULL, 51 FINLEY, 50 WARD, 49 LEWIS, 48 JOHNSON, 47 ANDERSON, 46 BROWN, 45 WASHINGTON, 44 AVERY, 43 CHANDLER, 42 KATELY, 41 RICHARDSON, 40 MORRIS, 39 JONES, 38 FOSTER, 37 REYNOLDS, 36 CHANDLER, 35 MAYO, 34 LOTTERBERRY, 33 PUGH, 32 COLES, 31 GROCE, 30 CASSIDY, 29 PERKINS, 28 ACKER, 27 JOHNSON, 26 CABEL, 25 PATTERSON, 24 FIELDS, 23 MARTIN, 22 REED, 21 SANFORD, 20 HALL, 19 MINNEY, 18 PONZO, 17 BURTON, 16 WEST, 15 PLATT, 14 ROBINSON COBBS, 13
57 RAMSEY, 56 WALKER, 55 REED, 54 SADLER, 53 WHEELER, 52 PRYOR, 51 MOSLEY, 50 SMITH, 49 FITTS, 48 McGRAW, 47 HULL, 46 JACKSON, 45 WATTS, 44 WINSTON, 43 HENRY, 42 MALORE, 41 HEYMAN, 40 STITT, 39 POLLARD, 38 HAND, 37 WARD, 36 WOODSON, 35 BUTLER, 34 TULLEY, 33 JACKSON, 32 BENNETT, 31 LONG, 30 HARRIS, 29 TRUSS, 28 WHITE, 27 JOHNSON, 26 DILLARD, 25 THOMAS, 24 BRYANT, 23 PARKER, 22 EASON, 21 HARPER, 20 ELLIS, 19 SADLER, 18 WALKER, 17 ALLEN, 16 PORTER, 15 PLATT, 14 HARDIN, 13 A. DAVIS LOGAN, 12
54 BRUCE, 53 FOSTER, 52 McWILLIAMS, 51 GAINES, 50 WOOD, 49 WINSTON, 48 OWENS, 47 FURR, 46 GUITON, 45 LIPSCOMB, 44 BORDEN, 43 TOHIAS, 42 BARFIELD, 41 LEWIS, 40 SCOTT, 39 DAVIS, 38 JOHNSON, 37 BAKER, 36 VAUGHN, 35 WALDEN, 34 ROGERS, 33 HENRY, 32 DUPREE, 31 McGRAW, 30 THOMAS, 29 BARNES, 28 BROWN, 27 FITTS, 26 BENNINGTON, 25 BOOKER, 24 V. BUSH, 23 GILES, 22 DAVIS, 21 RATLIFF, 20 GREEN, 19 BRISTLE, 18 JOHNSON, 17 GOFORTH, 16 GREEN, 15 SMITH, 14 DANDRIDGE, 13 YARBOURGH, 12 WM. MARTIN BURTON, 11
51 MINNIE, 50 ALLEN, 49 TRAINER, 48 SMITH, 47 POOLE, 46 WILLIAMS, 45 GODSEY, 44 JOHNSON, 43 BINFORD, 42 BAKER, 41 WRIGHT, 40 JONES, 39 A. BRYANT, 38 STROTHERS, 37 GRAYSON, 36 GRAY, 35 LIGHTFOOT, 34 EVANS, 33 HOWARD, 32 ALLEN, 31 KELLY, 30 DREW, 29 CHANDLER, 28 WASHINGTON, 27 LYNCH, 26 THOMAS, 25 ROSS, 24 WASHINGTON, 23 JOHNSON, 22 ORR, 21 AMEN, 20 RATLIFF, 19 ALEXANDER, 18 WINTERS, 17 ANKRUM, 16 CAMPBELL, 15 JORDAN, 14 WILLIAMS, 13 TOBIAS, 12 KELLEY, 11 JEFFERSON, 10
50 MARSH, 49 ANDERSON, 48 E. LEE, 47 WEBB, 46 WILLIAMS, 45 THOMAS, 44 MILLER, 43 CATLIN, 42 GRANT, 41 BOWLING, 40 THOMAS, 39 PORTER, 38 ALLEN, 37 HARRIS, 36 WILLIAMS, 35 CARKISH WILLARD, 34 WELLS, 33 JOHNSON, 32 JOHNSON, 31 REED, 30 NICHOLS, 29 MOORE, 28 ELLIS, 27 BROWN, 26 CHAPMAN COMER, 25 PHILLIPS, 24 KELLOGG, 23 MATTEN, 22 SNOWDEN, 21 ANDERSON, 20 BUCKLEY, 19 RAINEY, 18 TURNER, 17 HULL, 16 KELLOGG, 15 GAINE, 14 JOHNSON, 13 COKER, 12 LONG, 11 McCARRELL, 10 EDMUNDS, 9
49 BRUCE, 48 WARE, 47 LOGAN, 46 SHEPPARD, 45 EDMONDS, 44 LAWS, 43 JOHNSON, 42 BELL, 41 BLOUNT, 40 MINS, 39 LINCOLN, 38 BUSSEY, 37 SCOTT, 36 JOHNSON, 35 CARTER, 34 HARRIS, 33 MORRISON, 32 McELRATH, 31 WILKERSON, 30 BARNES, 29 BROWN, 28 FRANKLIN, 27 ADAMS, 26 ANDERSON, 25 SMITH, 24 BLACKSON, 23 MEREDITH, 22 NEWRING, 21 BOOKER, 20 JOHNSON, 19 JOHNSON, 18 HALL, 17 JACKSON, 16 FORNAIRE, 15 SAUNDERS, 14 GAINER, 13 PROCTOR, 12 HOWARD, 11 MAYS, 10 POLLARD, 9 CHILDS, 8 JENKINS
48 MARTIN, 47 DANTZLER, 46 WRIGHT, 45 BAKER, 44 SMITH, 43 GRAYSON, 42 PATTERSON, 41 ROBINSON, 40 BANKS, 39 EUBANKS, 38 LONG, 37 HAYES, 36 WILLIAMSON, 35 BANNISTER, 34 OWENS, 33 TURNER, 32 THOMAS, 31 JACOBS, 30 WARD, 29 WATSON, 28 PALMER, 27 WELLS, 26 SARGENT, 25 BRADY, 24 POPE, 23 BROWN, 22 JORDAN, 21 KING, 20 FRANKLIN, 19 WILLIAMS, 18 GROSS, 17 MATTHEWS, 16 WRIGHT, 15 HARRIS, 14 WASHINGTON, 13 BELL, 12 REAVES, 11 ANDREWS, 10 ALEXANDER, 9 LEE, 8 DAVIS, 7 GREEN
48, 47, 46, 45, 44, 43, 42 Thomas, 41 LACEY, 40 TAYLOR, 39 GRAYSON, 38 SAUNDERS, 37 PADMORE, 36 McDONALD, 35 DYRES, 34 SAWYER, 33 STOKES, 32 HARMON, 31 MITCHELL, 30 WORHMAN, 29 CAFFEE, 28 SCOTT, 27 EUBANKS, 26 WATKINS, 25 FIELDS, 24 COSTER, 23 GREEN, 22 BRUCE, 21 DAVIS, 20 BROWN, 19 WALDEN, 18 BROWN, 17 TAYLOR, 16 FOMDY, 15 CAMPBELL, 14 GRANT, 13 WALLACE, 12 SMITH, 11 BASKIN, 10 WALKER, 9 ADAMS, 8 EDDINS, 7 KNIGHT, 6 BARRINGER
49, 48, 47 LEWIS, 46 SAMS, 45 Williams, 44 HANCOCK, 43 WILLIAMS, 42 LEWIS, 41 JOHNSON, 40 REYNOLDS, 39 LACEY, 38 SMITH, 37 RICHARDS, 36 CHILDS, 35 WILSON, 34 ACKERS, 33 SCHIVERS, 32 ARCHIBALD, 31 DREW, 30 BROWN, 29 WALLACE, 28 ZELLNER, 27 McKINNEY, 26 DILLARD, 25 PARKER, 24 MORTON, 23 TOBIAS, 22 KILGORE, 21 GRAYSON, 20 KILGORE, 19 GOE, 18 WALDEN, 17 PROPPS, 16 JACKSON, 15 BURTON, 14 HENRY, 13 ROBINSON, 12 MARSH, 11 WITCHER, 10 LEWIS, 9 JACKSON, 8 EUBANKS, 7 SHACKELFORD, 6 PACE, 5 THOMAS
49 WILLIAMS, 48 GRAY, 47 ADAMS, 46 WHEELER, 45 BLOER DILLARD, 44 MALONE, 43 WARNACK, 42 SMITH, 41 HILL, 40 POLLARD, 39 POINDEXTER HOWARD, 38 BOGAN GRAYSON, 37 NASH, 36 YANCEY, 35 HARRIS, 34 ADAMS, 33 WHITE, 32 TURNER, 31 PATE, 30 JACKSON, 29 WILLIAMSON, 28 BAKER, 27 LOVELY, 26 MALONE, 25 ANDERSON, 24 LIPSCOMB, 23 PLATT, 22 HOWARD, 21 ADAMS, 20 YOUNG, 19 WHEELER, 18 FRYE, 17 HANCOCK, 16 BAKER, 15 HARRIS, 14 BURTON, 13 JOHNSON, 12 HOLMES, 11 SHERMAN, 10 STROTHERS, 9 LOGAN, 8 COTTON, 7 HARRIS, 6 DEFROSS, 5 CHRISTMAN, 4 COOK, 3
53, 52, 51, 50 COMEDY, 49 DENSON, 48 CLARK, 47 WASHINGTON, 46 REED, 45 FIELDS, 44 DIXON, 43 WILLIAMSON, 42 BOGAN, 41 JONES, 40 HILL, 39 JOHNSON, 38 VADEN, 37 GREY, 36 PATRICK, 35 FIELDS, 34 WHEELER, 33 HUNTER, 32 ASBURY, 31 PARKER, 30 PUGH, 29 HAIRSTON, 28 ANDERSON, 27 GODFREY, 26 JOHNSON, 25 JACKSON, 24 ROSS, 23 PATE, 22 LAMB, 21 HINTON, 20 HAWKINS, 19 LOWRY, 18 LAWRENCE, 17 HAYES, 16 BOLDEN, 15 LEE, 14 SCOTT, 13 THOMAS, 12 LEWIS, 11 ANDERSON, 10 MARTIN, 9 LITTLEBERRY, 8 SLADE, 7 THOMAS THOMAS, 6 FURR, 5 BECKNER, 4 WALTERS, 3 EDWARDS, 2
53 WELDON, 52 WELDON, 51 GLOVER, 50 WINSTON, 49 DAVIS WALLS, 48 GREGG, 47 HALL, 46 ANDERSON, 45 CROCKTON, 44 LOTTERBERRY, 43 JONES, 42 DAVIS, 41 MATHEWS, 40 LOVELACE, 39 CHAPMAN, 38 BRAWLEY, 37 ELLIS, 36 WHEELER, 35 HARRIS, 34 CROSON, 33 WASHINGTON, 32 HARRIS, 31 JENNINGS, 30 DAVIS, 29 TRENT, 28 WILLIAMS, 27 BIGHAM, 26 BLACK, 25 EVANS, 24 HALL, 23 WARB, 22 BRUCE, 21 ANDERSON, 20 LINDSAY, 19 CLARK, 18 RAULS, 17 WASHINGTON, 16 MASON, 15 WHITE, 14 HALL, 13 BICE, 12 MATHEWS, 11 LEE, 10 JACKSON, 9 WILLIAMS, 8 LYNCH, 7 STEEL, 6 BURGESS, 5 DILLARD CHAMBERS, 4 WALLACE, 3 SIMS, 2 SIMS, 1
53 BROWN, 52 BROWN, 51 WRIGHT, 50 WRIGHT, 49 BROWN, 48 WHITE, 47 LEE HARRIS, 46 CARTER, 45 GRIM, 44 LEWIS, 43 WILSON, 42 WHEELER HULL, 41 WHITESIDE, 40 MINOR, 39 GRAY, 38 TALLISON, 37 BROWN, 36 FRAZIER, 35 PENDLETON, 34 MINOR, 33 TYLER, 32 McGILL, 31 McGRUDER, 30 PONZO, 29 SHIVERS, 28 POLLARD, 27 SHERROW, 26 LOGAN, 25 WEBB, 24 BURNEY, 23 BYERS, 22 BURTON, 21 BOLING, 20 BURLEIGH, 19 JOHNSON, 18 BEARD, 17 COLEMAN, 16 WISE, 15 HORTON, 14 WADE, 13 HARISTON, 12 WOOD, 11 McCLANE, 10 SHORTERS, 9 WATSON, 8 DAVIS, 7 THOMAS, 6 MORRIS, 5 IRVIN, 4 PARKER, 3 PATMON
53 MINNIE, 52 BARNETT, 51 JOHNSON, 50 PLUMER, 49 MITCHELL, 48, 47 HOLMES, 46 CASTLE, 45 THOMAS, 44 EUBANKS, 43 HUDSON, 42 STROTHERS, 41 FORD, 40 THOMPSON, 39 KISNER, 38 PUGH, 37 CORNELIUS, 36 COCHRAN, 35 KING, 34 ADAMS, 33 MOSLEY, 32 COLEMAN, 31 DICKERSON, 30 DERRY SMITH, 29 HARRIS, 28 DIXON, 27 WASHINGTON, 26 HILL, 25 MARSHALL, 24 OWENS, 23 EVANS, 22 PONZO, 21 WINSTON, 20 BANKS, 19 WHEELER, 18 WARD, 17 WASHINGTON, 16 WISE, 15 SANDERS, 14 BURTON, 13 LYNN, 12 BEARD, 11 RATLEY, 10
49, 48, 47 SMITH, 46 TATE, 45 MOORE, 44 WHEELER, 43 BURGESS, 42 McFARLAND, 41 BARBOUR, 40 THOMAS, 39 BAKER, 38 McGOWN, 37 MICKLE, 36 BROOKS, 35 BROOKS, 34 THOMAS, 33 BURLEIGH, 32 BROWN, 31 ALLEN, 30 LIPSCOMP, 29 BARKER, 28 RATLIFF, 27 RATLIFF, 26 HIGHGATE, 25 DURHAM, 24 DENNIS, 23, 22, 21, 20, 19, 18, 17, 16
46, 45, 44, 43, 42, 41 YOUNG, 40, 39, 38 WHEELER, 37 CLARK, 36 LOFTON, 35, 34 CAMPBELL, 33, 32 RALPH, 31 SWEENEY, 30 WILEY, 29 WILEY, 28, 27, 26, 25

BLOCK 13

Grave	A	B	C	D	E	F	G	H	I	J	K	L	M
51	S. MALONE	JENNINGS	BAILEY	FLEMING	WALLACE 39								
50	S. JACKSON	L. FRAZIER	S. BAILEY	W. HUGHES	AKERS 38	LOTTERBERRY	BRACKETT						
49	G. AVERY	D. ASBURY	BOOKER	HIRSTON	DANDRIDGE 37	PLUMMER				WILSON	THOMAS		
48	W. SHEPPARD	ELLIOTT	COMEDY	McCORMICK	X	MARTIN				WILSON	BOWEY (WILSON)	CHATMAN	X
47	M. ASBURY	D. RAMSEY	WHEELER	RICHARDSON	?	LIGHTFOOT				TURNER	(BRIDGES) BOWEY	CHATMAN	WINSTON
46	B. MANLEY	B. FLOWERS	JOHNSTON	LIGHTFOOT	BRUCE 35	EVANS				DILLARD	BOWEY	PARKER	WINSTON
45	WEBB	E. PALMER	LOCKETT	CARROLL	PEARL CARROLL 34	CARROLL						LYNCH	WINSTON
44	LONG	A. GIBSON	F. BRUCE	BANSON	BENNETT 33						CULP	JOHNSON	
43	L. JOHNSON	F. NIX	T. ADAMS	SHEPHARD	?		← NO SALE →	← NO SALE →	← NO SALE →			FERGUSON	
42	C. ADAMS	MINOR	JAMES W. JACKSON	PETTIS	? NO SPACE AVAILABLE							GARRISON	
41	N. MOORE	JONES	X	HULL	?								
40	DAVIS	BRUCE	HILL	MOORE	?	← NO SALE →							
39	PORTER	SMITH	HALEY	LEWIS	?					← NO SALE →			
38	BARBER	CHANDLER	ANDERSON	HARVEY	?								
37	LONDEN	LEWIS	HODGENS	BENSON	NO SALE				[illegible]				
36	WALLACE	JOHNSON	LOVELY	STAFFORD			CALLOWAY	RITTER	WATTS				
35	JONES	MEREDITH	LAMB	LYDIA FRAZIER			DILLARD	MERIWEATHER	MONTGOMERY				
34	STROTHERS	JONES	GORDON	G. McCRARY			DILLARD	MERIWEATHER	MERIWEATHER				
33	LEWIS	ARRINGTON	VADEN	A. LIPSCOMB		X	CAMPBELL	CAMPBELL	Lightfoot BOOKER				
32	RIGGINS	BURTON	HAIRSTON	J. HARVEY	BENNETT 32	ADAMS	CAMPBELL	CAMPBELL	THOMPSON TENSLEY	Thompson			
31	THOMAS	DANGERFELD	JENNINGS	F. BROWN	THOMAS	ADAMS	McKENZIE	PRENTICE	CRAWFORD	Thompson			
30	WILSON	WILLIAMSON	BESSIE ADAMS	B. ANDREWS	WILSON	BRUCE	SADLER	McKENZIE	ROBINSON	Thompson			
29	REDMOND	LOCKLEY	BENNETT	G. JONES	FINDERMARK	BRUCE	HARRIS	Porter	ROSS	Thompson			
28	A. KERR M. BEARD	HILL	MENVEL	EDNA COTTON	HUGHES	NAPPER	FABICH	Asbury	ROSS	Thompson			
27	HALL	JACKSON	COLEMAN	S.E. WATTS	JACKSON	JACKSON	MILLS	CRAWFORD	NAPPER-JACKSON	NO SALE			
26	VINCENT	REED	WARD	WADE	BAKER	TERRELL	GRINAGE	McCOY	NAPPER-JACKSON	DRAIN			
25	DUMAS	ELLIS	GREENWOOD	X	BAKER	SMITH	DUGGAN	McCLOSKEY	McCLOSKEY				
24	JONES	X	BROWN	X	WHEELER	HAGAN 24	COCHRAN	BRITTON	REED				
23	LEWIS	JOHNSON	BRYANT	CATHERINE BROWN	WHEELER	ANDERSON 23	GULLICK	DATES	AKU				
22	CHANDLER	CATLIN	MINOR	LEE ETHEL WOODS	STEELE	GATLING	GULLICK	CAMPBELL	CHANDLER				
21	FRANKLIN	I. HARRIS	LACEY	THOMAS WEST	DILLARD	SMITH	BRODAK	CAMPBELL	CHANDLER				
20	HAIRSTON	JONES	STOKES	LOST SPACE *20	PARKER	CHANEY	NO SALE	RATLEY	CHANDLER				
19	PRENTICE	SIMS	MOORE	BANKS	WASHINGTON	HAGEN	NO SALE	DATES	WINGREEN				
18	BRAUN	JACKSON	THOMAS	X	ELLIOTT	MORMAN	NO SALE	GRINAGE	WINGREEN				
17	THOMAS	ANDERSON	MILLS	X	RATLIFF	PRUITT	NO SALE	MORMAN	CHANDLER				
16	STARR	PHILLIPS	JONES	ADAMS	LIGHTFOOT	JOHNSON	NO SALE	PINSON	CHANDLER				
15	ADAMS	WILLIAMSON	BENNETT	LEWIS	THORNTON	MERIWEATHER	NO SALE	WASHINGTON					
14	MOSLEY	G. ROSS	THOMAS	STROTHERS	STANKO	CULP	NO SALE	WASHINGTON					
13	WILLIAMS	J. FRANKLIN	BROWN	GORDON	BURNETT	JUDA CAMPBELL	NO SALE	WASHINGTON					
12	TERHUNE	PRIME	WHEELER	BROWN	WARE	R ANDREW JACKSON	MORMAN	WASHINGTON					
11	SMITH	STONER	JOHNSON	HELEN LOGAN	HAMILTON	[illegible]	REYNOLDS	MATHIS					
10	KELLY	LONG	BROWN	SAMUEL PARKER	WATSON	FLEMING	BOOKER						
9	COLE	THOMAS	CARTER	JENNIE LEWIS	DERRY	HARRIS	ADAMS						
8	PATTERSON	LARNET	RATLIFF	MARY MOORE	DERRY	JOLLY	PHILLIPS						
7	NELSON	MINOR	HARRIS	DOROTHY CHANDLER	WILLIAMS	HUGHES	BOBER						
6	USED GROUND	ADAMS	DILLARD	ROXIE BUSSEY	WILLIAMS	LIGHTFOOT	GORDON						
5	USED GROUND	X	ROBINSON	CALLEY HARPER	WADE	BEARD							
4	LONG	X	X	NETTIE WILKINS	LEWIS	WILSON	STICKLES						
3	WARE	WELLS	X	HARRY DREW	SMITH	BOBER	X						
2	GORDON	RACHEL DILLARD	MONROE GOWDY	ESTELLA MORRIS	THOMAS	X							
1	WILLIAMSON	BESSIE JONES	FRANK BLAKE	MARY MACK	HENDERSON	X							
00	BURGESS	GRAYSON	BENNETT	TERRELL	LIGHTFOOT								
00A	LINHART	GRAYSON	GRAYSON	LIGHTFOOT	LIGHTFOOT								
00B		LIGHTFOOT	BALLENTYNE	LIGHTFOOT									
00C		Eddie BENNETT Jr.	CARRIE BENNETT	LIGHTFOOT									

CREMATION ONLY

CREMATION ONLY

CREMATION ONLY

* NOTE: THERE IS NO #48 IN RANGE "E". SPACE IS LOST.

RANGE "E" BEGINNING WITH GRAVE #5, SPACES HAVE BEEN RE-PLOTTED TO A 4' WIDTH. 9-21-85. THEREFORE, RANGE "E" BURIALS WILL NOT ALIGN WITH RANGE "D" BURIALS.

M L K J I H G F E D C B

(B) (A)

N

O

N

— = STAB SPLITS LOT

O = LOT #

RETURN ONLY

	M	L	K	J	I	H	G	F	E	D	C	B	
X	58 HANNA	HARTON 58 HAYS	X 58 HAAS	HUPP 58 PARSONS	BAKER 58 HOPKINS	FENNELL 58 MASS McCRACKEN	YOUNG 58 BLACK	HUDAK 58 KNIGHT	LOWERY 58 McVEIGH	CHOPP 58 PRIGG	58 BONUS	58
X	57	COLE 57 COLE	X 57 HAAS	HULL 57 CRAWFORD	PETERS 57 MEEKS	ASHMORE 57 WOOD	ANDRETTI 57 JOHNSON	MARTIN 57 STONE	SAKERKA 57 STALEY	HOUSTON 57	Yiggins 57 SMITH	57
X	56 PIATT	STETSON 56 LEWIS	LEWIS 56 GAILLT	GILBERT 56 MALOY	McADOO 56 SEIBERT	RIZZO 56 DASKE	SAMPSON 56 REDUNGER	CAGE 56 BECKNER	GUMP 56 SCHRODER	56 DESMOND	Hurbere 56 DENMAN	56
X	55	JACQUES 55 MARKHAM	MARTIN 55 FUGLER	BRINGER 55 OGNAG	McNURLEN 55 COREY	RAIPE 55 ANKROM	HOLTZINER 55 RIHS	SHRIVER 55 PAUKOVICH	GORDON 55 SCOTT	TROUTMAN 55 MIESEL	Wallace 55 MALONE	55
X	54	PIERCE 54 McCARTNEY	CAGLE 54 BARRELS	REEDY 54 KASAUICH	KEENER 54 KEGLER	FARLEY 54 LETA	EIMER 54 ELLIOTT	FETUS 54 McFALL	WYLER 54 MULL	OPATT 54 SULITZ	Brethen 54 MOORE	54
X	53 SHRIVER	YATER 53 URISTA	SYKORA 53 FLANAGAN	DEBBIS 53 LUCAS	Reynolds 53 HAUGHT	BYRNES 53 HUFFMAN	COTTRELL 53 WRIGHT	DAY 53 KREIDER	CROW 53 ROBERTS	WILKES 53 ACKLEY	Elmore 53 BARR	53
X	52	YOUNG 52 HUTCHINSON	BYRNE 52 WYNN	WILLIAMS 52 Phillips	HIGGIN 52 BOTHAM CHARLTON	KIDWELL 52 REDLINGER	MORGAN 52 FISCHER	ROBSON 52 IRELAND	CHANEY 52 RUSH	ROMANO 52 McVAY	Mc Kinnon 52 ARMSTRONG	52
X	NOVOTNY 51 NOVOTNEY	ANDRE 51 TRAVERS	CAREY 51 MARTINEZ	GARBINSKI 51 POLAND	JESTAT 51 LUCY	MUNROY 51 POLLOCK	PETTIT 51 HOOPER	PLANTS 51 BERDINE	McFALL 51 UNKNOWN	CONIC 51 DOEFLER	Kenneth 51 INFANT GIRT	51
X	50	KEENER 50 BELL	Wagner 50 Schlick	GALLED 50 PAUKOVICH	KEENER 50 CONTORAKAS	HUNNELL 50 BROMLEY	LYNCH 50 SCARIOT	CONKLIN 50 CONKLIN	SIMMS 50 PARKISON	MONTGOMERY 50 SECZOTKA HARTLEH	Boyd 50 CHAMBER	50
X	49	TATOLORICH 49 Haberen	Hoisington 49 Garb	HARVEY 49 CHARLTON	AMOS 49 HALL ARBIBAST	MITCHELL 49 DEYELL	WARRICK 49 VAN BRIGGLE	CONNER 49 SMITH	ALLEN 49 WORKMAN	SHADLE 49 MERRIWEATHER	GRADY 49 ZENTZ	49
HOLMES	48	SKOLYAK 48 SHRADER	48 Barnes	AHWEST 48 GEORGE	HALL 48	SCOTT 48 BELL	LONG 48 RUSH	BARD 48 WILLIAMS	HOBART 48 JOHNSON	MONTGOMERY 48 WINGARD	CHANDLER 48 CASS	48
X	47	LOUGHMAN 47 LITTON	47 Johnson	ANDERSON 47 SEIBERT	47 HARVEY	ANTIL 47 REEDY	UNKNOWN 47 CALDWELL	MIHER 47 McCARTNEY	MUELLER 47	LITTON 47 NELSON	Miller 47 GLOH-DENNING	47
46	EALY	RINGER 46 STEWARD	GABBERT 46	SHIRLEY 46 GARRETT	SPIRO 46 MANSFIELD	LABRASKY 46 PAYSON	LINDLEY 46 CAPO	TURNER 46	WILLIAMS 46 BURGESS	SING 46 McANN	Vanbrunen 46 GATTEN	46
45	X	HINDMAN 45 WELLS	45 Gilmer	45 BELCASTRO	QUAICH 45 BAYNE	WILLISON 45 KLIER	45 HICKERS	McWHORTER 45 STETSON	SLONEKER 45 McCLELLAND	PORTER 45 DALDIA	BYERS 45 BYERS	45
44	FLORY	44 WILT	Wright 44	BRANER 44 HEWITT	CALDWELL 44 HECKMAN	McGOWAN 44 BEIGHLE	SORICH 44 MORRIS	SIMMS 44 SHAW	PETTIT 44 BELL	REEDY 44 BUTCHER	SIBERT 44 MOLINARO FALLEN	44
43		43	43 Hawkins	BRANER 43 KNIGHT	HARRIS 43 HILDRE BRAND	SPROWLS 43	ROGERS 43 HALL	WADE 43 Baker	CALVERT 43 McKINLEY	McADOO 43 GREER	Tinsley 43 PLOCK	43
42	BERNER	BODNOVER 42 CONKLIN	DUNN 42	SIMMS 42 WATTS	GUILDAS 42 HOTT	KNOX 42 MANNING	KROER 42 SIMMS	CROUSE 42 McVey	KEENAN 42 ASBURY	O'BRIEN 42 BAYNE	Norman 42 WRIGHT	42
41	X	41 PETTIS	41 Mareis	DEREN 41 HANEY	MELLARS 41 HARRISTON	WATKINS 41 MELONE	HAMM 41 SAUNDERS	ROSA 41 DeSai	DUCKWORTH 41 JOHNSON	LONG 41 PIEMME	Milton 41 HUMPHREYS	41
40	DALGHERTY	40	Parmida 40	BRIGGS 40 DAMEROW	CRAIG 40 FARMINGTON	KENNEDY 40 MOORE	S 40 PRYOR	GIESEK 40 ROSLIN	UNKNOWN 40 KAUFER	SPRINGER 40 DOYLE	HELMICK 40 COYNE	40
39		HAIRSTON 39 WEAVER	39 Hunter	PALLEN 39 HOOVER	DEREN 39 BERISFORD	39 Barnes	KREIDER 39 HUNT	GUMP 39 Burton	GOMER 39 BUTLER	CLEMENS 39 RASHAD	HUFFER 39 BARNHART	39
38	Johnson	38 OWENS	Borrow 38	VERCHUCK 38 MULLEN	VERGER 38 McCOR	McCULLOUGH 38	ASCHERMA 38	ARENT 38 Gill	ALRUTZ 38	BROWN 38 WILLIAMS	Florence 38 DAHNS	38
37		37	37 Beatty	DULANEY 37 LITMAN	37	37 De Sarno	HOARDLEY 37 ROTH	HARVEY 37 PINKERTON	CONTE 37 McELHANEY	CANTELLA TWINS 37 Thompson	THOMPSON 37 HAPP	37
36	Shuttles Worth	ROE 36 ZRIMSEK	36	36	36	36 WICE 36		Harris 36	36 KAPOSY	MOUND 36 McMASTERS	Lytton 36 WRIGHT	36
35		PENDLEND 35 ZRIMSEK	35 Gallo	35 Wilcox	35	35 Ellis	35 Carl	Mackowski 35 Lundgren Dunn FETUS	DAY 35 Frank	Welch 35 LOWE	McClain 35 DAVEY	35
34		WARREN MANS 34 COX	34	34	34	34	34	34	COX 34 JUSTIN	Frio 34 COLE	Bohal 34 BARNES	34
33		33 COX	33 Carpenter	33	33	33	33	33	33 WEIR	RUDY 33 KOBUCI	Fazekas 33 NIXON	33
32		32 McGAVITT 32	Phillips 32	32	32	32	32	32	32 DUTCHER	Stroqis 32 WRIGHT	Wilt 32 CRUM	32
31		Gibson 31 Gillespie	31 Johnson	31	31	31	31	31	31 Bonazzin	EICEL BERG 31 ROSELIO	Edward 31 CAIN	31
30		30	McMaster 30	30	30	30	30	30	30 NONAME INFANT	SKIDMORE 30 BLAZE	HARTZELL 30 HARTZELL	30
29		LANGHAM 29	29 DEAN	29 CAIN	29	29	29	29	29	HOBBS 29 BERRICK	Green 29 Boyd	29
28		RISNER JR 28 SCHROEDER	28	28	28	28	28	28	COLE 28 PARKINSON	ELLIS 28 [illegible]	Smith 28 HALL	28
27		27	RUBEN STEIN 27									27
26		26	26									26
25		25	25									25
24		24	24									24
23		23	23									23
22		22	22									22
21		21	21									21
20		20	20									20
19		19	19									19
18		18	18									18
17		17	17									17
16		16	16									16
15		15	15									15
14		14	14									14
13		13	13									13
12		12	12									12
11		11	11									11
10		10	10									10
9		9	9									9
8		8	8									8
7		7	7									7
6		6	6									6
5		5	5									5
4		4	4	4	4	4	4	4	4	4	4	
3		3	3	3	3	3	3	3	3			
		2	2	2	2	2						
		1	1									

NO BURIALS BEYOND THIS POINT

28 East grave

NUMBERS ARE LOCATED TOP-RIGHT HAND corner

W 1/2

E 1/2

NOTE:
DO NOT SELL ANY GRAVES PAST THE NUMBER "28" IN ANY ROWS.

BLOCK 16

M	L	K	J	I	H	G	F	E	D	C	B	A
50 H. VONBURGE	50 E. WELCH	50 Z. WONSETTLER	50 J. STEEL	50 E. AMMON	50 I. BROWNSON	50 C. HEADLEY	50 W. JOHNSON	50 A. GARDEI	50 H. CAIN	50 F. SWANEY	50 S. KINNAN	50
49 J. RUSH	49 A. WELCH	49 H. WONSETTLER	49 M. STEEL	49 L. AMMON	49	49 R. HEADLEY	49	49 V. GARDEI	49 CAIN	49 M. SWANEY	49 M. KINNAN	49
48 R. RUSH	48 M. KOTTWER	48	48 R. BERGER	48 E. Riggle	48 H. PERCIVAL	48 B. McLAURINE	48 J. BEATTY	48 J. JOHNSON	48 L. BAKER	48 A. BOOHER	48 J. WAMPLEK	48
47 T. PARKER	47 E. BYERS	47	47 M. LEYDA	47 J. PORTER	47 M. PERCIVAL	47 P. McLAURINE	47 H. BEATTY	47 J. MAURER	47 L. BAKER	47 W. FISHER	47 M. SMITH	47
46 PARKER	46 J. ARNOLD	46 E. RIGGLE	46 R. GRANDON	46 M. PORTER	46 C. HAYS	46 E. ROSS	46 C. MEEKS	46 J. WHEATLEY	46 H. BORROR	46 C. Moore Fisher	46 A. MEEKS	46
45 T. STEWART	45 E. EMERY	45 G. BUSH	45 B. MACK	45 S. MEDLIN	45 S. LESTAK	45 V. Mouseris	45 I. PHILIP J. MAURRER	45 H. WHEATLEY	45 E. BORROR	45 J. BOBACK	45 D. GARRETT	45
44 D. SLIMAN	44 A. AMON	44 C. MANNON	44 D. GLOVER D. GLOVER	44 C. BOYD	44 J. MITCHELL	44 E. MOUNTS D. HASLAGE	44 J. MOUSMANIS	44 A. WHEATLEY	44 I. AMON J. AMON	44 J. LYNN	44 H. GARRETT	44
43 E. HODGKINSON	43 R.A. WURTZER	43 M. SAYER	43 N. NEWMAN	43 T. BABBITT	43 MITCHELL	43 C. TUTTLE	43 A. MOUSMANIS	43 A. ASHMORE M. ASHMORE	43 J. BOYD	43 H. LOUGHMAN	43	43
42 M. AMSLOW	42 H. WALTERS	42 A. BABBITT	42 W. BURNETTE I. BURNETTE	42 E. EWART	42 H. Nordock	42 S. VATULANO	42 W. DOBBINS	42 W. FRANK	42 C. BOYD	42 F. Henderson	42	42
41 I. ANTHONY	41 M. KISER	41 P. O'BRIEN	41 M. LUELLEN	41 M. FAIRLEY	41 M. Nordock	41 A. Mouseris	41 L. DOBBINS	41 M. FRANK	41 F. MOORE	41 S. ANTILL	41	41
40 L. PHILIPS E. DICKS J. KING	40 C. GUNDEROTH	40 J. PETTIT	40 H. MILLER	40 G. LOAR	40 E. BAKER	40 S. BENNETT	40 J. PETTIT	40 J. MALINAK M. MIHALOVICH	40 F. MOORE	40 D. DONLEY	40 J. ROBERTS	40
39 H. ADAMS	39 J. KETTERING	39 A. GRAY	39 H. MILLER	39 H. LOAR	39 D. PIATT	39 L. GATES	39 R. BROWNLEE	39 M. YOSICH	39 G. MOORE	39 W. McCARTNEY	39 M. ROBERTS	39
38 S. McCOMBS W. REED	38 W. WISE	38 A. SLIMAN	38 M. BINNER	38 P. Pilch	38 M. HECKMAN	38 R. GATES	38 S. KIRBY	38 L. McVEE	38 G. MOORE	38 O. McCUEN	38 ROBERTS	38
37 R. BIGNELL	37 S. CRUMRINE	37 J. FOFLYGEN	37 W. COURTWRIGHT	37 G. LITTLE	37 L. Luchese	37 M. GREDESKY	37 C. MILLER	37 J. SHILLING	37 G. NEWMAN	37 F. McCUEN	37 R. Maurer	37
36 C. FORD G. TAYLOR	36 J. WHITE E. WHITE	36 J. MALOY	36 A. Phillips	36 M. WILSON	36 C. ALLEN	36 S. STEFFEK	36 Mr. BROZIOVID	36 J. CHESTER	36 H. HUFFINE	36 J. McCUEN	36 P. RUSCHELL	36
35 F. TAYLOR	35 D. LYCETT	35 J. MALOY	35 W. HARRIS	35 J. ENGLE	35 A. PELCH	35 R. CONKEY	35 W. BOYER	35 M. HUFFINE	35 C. HUFFINE	35 J. MERCER	35 C. ALEXANDER	35
34 I. BRADFORD C. LEEPER	34 N. CROSS	34 I. YOUNG T. YOUNG	34 W. McCARTNEY	34 G. NEFF	34 S. KING	34 P. Lindberg	34 M. MACKEY	34 H. MACKEY	34 N. HIXENBAUGH	34 G. MERCER	34 S. SANTO	34
33 R.C. LEWIS	33 R. WILSON	33 F. MOORE	33 C. KING	33 S. RUSH	33 F. KING	33 N. TEMPLE	33 R. FRIEND	33 R. SWAN	33 M. HIXENBAUGH	33 A. WRIGHT	33 W. KING	33
32 A. LEWIS N. LEWIS	32 R. WILSON A. WILSON	32 T. MOORE	32 E. WHITEMAN	32 J. MARSHALL	32 N. KING	32 V. SHIRES	32 M. CROXTON	32 C. WISEMAN	32 C. KING	32 E. WRIGHT WICK	32 P. NOACK	32
31 D. NELSON	31 E. WURTZER	31 H. WILLIAMSON	31 S. KUBICYE	31 MARSHALL	31 M. HOWELL	31 W. LYTLE	31 C. WILSON	31 I. WELCH L. WRIGHT	31 A. ENGLE	31 H. HALL	31 P. NOACK	31
30 F. BISSETT	30 J. ENGLAND	30 N. Williamson	30 J. MAGGAR	30 I. BANE	30 J. SNYDER	30 H. HARMAN	30 M. WILSON	30 E. FARLEY	30 A. Shawinski	30 M. GOUGH	30 J. McCARTNEY	30
29 G. REAZ	29 M. SICKELS	29 I. DAUGHTERY	29 G. WHITE	29 J. AGNEW	29 M. DANIELS	29 A. SPEASE	29 L. COMMONS	29 F. CRAWFORD	29 M. RABER W. RABER	29 J. KELLEY J. KELLEY	29 C. KING	29
28 M. BARRETT	28 A. BANE	28 J. POLITE	28 E. CHAPMAN	28 C. CLUTTER	28 R. DANIELS	28 N. BEISFORD V. BEISFORD J. BEISFORD	28 N. CRAWFORD	28 D. STALEY	28 I. R. RABER H. RABER	28 M. KELLEY	28 P. BROOKMAN	28
27 S. ABRAHAM	27 N. BANE	27 V. POSEGSKI	27 S. HATFIELD	27 T. BOARDLEY	27 H. MORRIS	27 E. BEISFORD	27 J. WISEMAN B. LOTCHRAN	27 W. WARD	27 M. HUFFMAN	27 REV. NAIRN	27 BROOKMAN	27
26 C. BERQUEST	26 I. SIEBERT E. BIRCH	26 T. JOHNSON E. JOHNSON	26 F. DAVIDSON	26 M. BOARDLEY	26 E. ROOD L. ROOD	26 A. HARMON	26 A. PILCH	26 C. FARRABEE	26 J. SCHEN	26 M. NAIRN	26 J. McCARTNEY	26
25 M. BERQUEST	25 J. JONES	25 T. JOHNSTON	25 M. DRURY	25 ECKLAND	25 P. REYNARO	25 R. DUCKER	25 J. DALEO M. DALEO	25 E. CHAMBERS	25 E. SCHEU	25 J. WHITEMAN	25 K. McCARTNEY	25
24 R. McCULLOUGH J. McCULLOUGH	24 J. MARSDEN	24 R. ALKIRE	24 E. STANTON	24 M. ECKLAND	24 A. WATSON	24 G. TURNER	24 P. JOHNS	24 J. CHAMBERS	24 G. HUFFMAN	24 A. STALEY	24	24
23 G. KING	23 R. ALLEN	23 C. CARREL	23 G. MILES	23 C. DONEL	23 J. NEWMAN	23 J. PACE	23 L. ANTILL	23 G. PIPPIS	23 J. NEEHOUSE I. NEEHOUSE	23 J.R. SICKLES	23 J. SOMBORA	23
22 J. WISE	22 GREER H. COHEN	22 W. Whitelatch	22 E. COFFEE	22 L. DONEL	22 D. FRENCH	22 K. BOURGHS	22 A. WIDLAND	22 I. WHITEMAN C. DALEY	22 W. BROCK	22 O. CLUTTER	22	22
21 E. TAYLOR	21 R. PATROVICK	21 R. MILES	21 J. KING	21 A. BRIGGS	21 M. STARINSKY	21 J. FISHER	21 W. GALAHER	21 L. GLENDENING	S. BROCK	21 C. CLUTTER	21	21
20 J. FOFLYGEN	20 S. FRAZER	20 S. DICKINSON	20 M. SHEETS	20 MITCHELL	20 S. FLORIDA	20 F. WOLFE	20 L. JAMES	20 G. GLENDENING	20 KOSEY W. AMON	20 W. RUTAN	20	20
19 W. LYLE	19 LOST - MILDRED SMITH - WILSON ANDERSONS	19 A. Wright	19 O. CRAWFORD	19 I. MITCHELL	19 E. BRUNO	19 S. ZIMMERMAN	19 A. McCLAIN	19 H. LINDLEY	19 M. AMON	19 F. HASTINGS	19 L. BROWN	19
18 W.R. SMITH	18 H. HUGGINS	18 D. GILLESPIE	18 M. CRAWFORD	18 E. SCHLANIPTZ	18 E. WHEELER	18 J. BRIGGS	18 O. PHILIPS	18 H. MEEKS	18 C. McCALL	18 R. FISHER	18 R. BROWN	18
17 M. ROSSER	17 D. SCHWERING	17 J. McSHERRY	17 S. SMITH S. MILLER	17 M. BROWN	17 H. SCHOLTEN	17 R. CARLILE	17 E. CARTER	17 H. ELIAS	M. BURGH	D. AGLER	17 E. BROWN	17
16 J. REID	16 S. RENNER	16 J. DALTON W. DALTON	16 J. MAIN	16 M. ROSS	16 E. KAPP	16 A. ADAMS	16 P. RICHARD	16 O. CARPENTER	16 L. DAGOSTINO	16 E. AGLER	16 J. IRWIN	16
15 R. DALMER	15 E. RENNER	15 M. HECKMAN	15 C. KAHL	15 G. COLE	15 L. STICKELS	15 M. KING	15 R. HOUSTON	15 J. GOUGH	15 DAGOSTINO	15 SEYBOLD	15 S. IRWIN	15
14 C. BIRD	14 T. JONES	14 J. McBRATNEY	14 F. BURKETT	14 J. DAY	14 J. ENOS	14 S. McDUGAL	14 A. GRATZ	14 E. RIPLEY	14 C. RIGGS	14 M. SEYBOLD	14 B. DONLEY	14
13 J. TUTTLE	13 M. CARROLL	13 S. McBRATNEY	13 J. BURKETT	13 J. McMULLEN	13 H. McSherry	13 M. McDUGAL	13 W. VARNER	13 R. RIPLEY	13 R. HIGGINS	13 T. BROOKS	13 O. DONLEY	13
12 W. MUNKS	12 V. BLOSS	12 W. WISE	12 C. Shabber	12 G. McMULLEN	12 F. McSHERRY	12 J. HAVACK	12 J. WATSON	12 H. BRIGGS	12 J. MAURY	12 M. BROOKS	12 J. KAHL	12
11 N. MUNKS	11 A. ELIAS	11 R. McMULLEN	11 S. Shabber	11 YORK	11 E. SMITH	11 B. NICKERSON	11 I. BRIGGS	11 C. GOOCH	11 O. MAURY	11 C. LYLE	11	11
10 R. BILLINGSLEY	10 M. CASSON	10 L. BEBOUT S. BEBOUT	10 T. SMITH	10 V. YORK	10 A. ADAMS	10 J. LYCETT	10 J. MILES	10 W. CAIN	10 J. ROBINSON	10 E. LYLE	10 E. McCLUSKEY	10
9	9 J. LLEWELLYN	9 S. WISE	9 J. MOORE	9 R. BROWNLEE	9 R. VANSICLE	9 J. HORTON	9 A. MILES	9 A. CAIN	9 R. Buenfield	9 M. Hovert	9 E. McCLUSKEY	9
8 E. MOORE	8 B. LLEWELLYN	8 T. McVAY	8 W. ALLEN	8 M. BRAHAM	8 F. SCHMIDT	8 M. HORTON	8 J. HEADLEY	8 G. T. BERT	8 F. Donley	8 Hovert	8 W. REEDY	8
7 T. MOORE	7 D. SMITH	7 V. BENNETT	7 E. ALLEN	7 E. BRAHAM	7 P. MILLER	7 W. WILSON	7 J. HEADLEY	7 M. BERT	7 G. PELKEY	7 J. MAZE	7 C. BRAHAM	7
6 T. HUGHES	6 I. SMITH	6 G. JONES	6 J. ANDERSON J. ANDERSON	6 K. GRIM	6 M. MILLER	6 L. HAYMAKER	6 CHRISTMAN	6 LINDBURGH	6 G. PELKEY	6 M. MAZE	6 G. SCHLEGEL	6
5 HUGHES STROSNIDER	5 E. LEWIS	5 C. McVICKER F. KNOX	5 J. ANDERSON	5 D. Craig	5 E. FISHER	5 W. GRIM W.C. GRIM	5 CHRISTMAN	5 LINDBERG LUNDBERG LINDBURGH	5 A. Swiderski	5 W. SPIKER	5 J. THOMAS	5
4 A. KNOX	4 W. STEPHENS	4 M. GORDON	4 T. ZOOK	4 G. WILKINSON C. FIELDS	4 N. Foflygen	4 E. GRIM	4	4 G. WOODRUFF	4 W. LEWIS	4 J. PRESTO	4 I. BROWN	4
3 N. VENGAIN	3 M. STEPHENS	3 W. IREY	3 A. ZOOK	3 A.C. HALL	3 J. ALLEN	3 A. WATERS	3 M. MITCHELL	3 R. WOODRUFF I. JOHNSON	3 R. WAGNER M. WAGNER	3 J. PRESTO J. PRESTO	3 K. BROWN J. CRAVEN	3
2 M. LAWTON	2 B. STEN	2 E. IREY	2 J. MAWHINNEY	2	2 M.G. BEATHOUSE	2 WATERS	2 N. DEXTER	2 G. PRATTON	2 E. JOHNSON	2 C. HAMPE	2 J. URBANIC	2
— M. McCULLOUGH	— J. STEN	— S. DESMONE	— L. MAWHINNEY	— A. HACKETT	— M. RYAN I. RYAN	— O. SMITH	— M. DEXTER	— M. PRATTON	— H. JOHNSON	— A. HUFFMAN	— I. COMPSTON	—

BLOCK 17

	B	C	D	E	F	G	H	I	J	K	L	M
—	M. ISAMINGER	M. WELSH	A. AMON	V. & TWIN MYERS	G. DUKATE	M. SHAFFER	R. GUMP	C. STOUT STOUT	M. CROWLEY	M. SNYDER B. HUGUS	E. HUGGINS	MILLER A. MILLER
2	A. SIMPSON	S. WELSH	R. PLYMIRE	G.J. & R. MYERS	DUKATE	W. BENNETT	E. HEWITT	F. STOUT	E. GRECO	M. HUGUS J. SNYDER J. BOUTWELL	D. HENDERSON	O. SWIEGER
3	P. SIMPSON	M. FAIR	N. PLYMIRE	MELARK	W. TURNER		H. HEWITT	N. STOUT STOUT	N. HOLMES	POLAND	H. JOHNSON	H. PARSONS
4	N. SIMPSON	W.R. MAZE	D. CRAIG	KINNAN	DENTZER	B. FRUM	M. KAEGAN	M. CLINE	HOLMES	A. POLAND	JOHNSON	M. TOENARY
5	D. SIMPSON	A. CHAPPEL	H. CRAIG	R. KINNAN	H. DENTZER	C. FRUM	M. WILLROFT WILLIAMS	RANDOLPH R. RANDOLPH	A. VARLEY	U. THOMPSON	TILLTON	E. TAYLOR
6	M. BYRNE	CHAPPEL	H. GORDON	D.M. RUSH	BAILEY	G. MORRIS	E. WILLIAMS	RANDOLPH	H. CHESTER	V. JOSEPH	M. BRIGHT	M. PINKERTON
7	RETTIG E. MOSIER	F. LUELLEN A. EVANS	GORDON	J. MAZE	C. BAILEY	A. MEEKS L. MEEKS	P. LUDEC	C. WISE E. MOUNTS		R. WILLIAMS	J. BRIGHT	S. MISKO
8	D. MOSIER	V. RUSH	J. BAKER	M. JAVENS DEVORE	P. CARPON CARPON	B. JOHNSON	D. PHILLIPS	L. TOLAND	H. TARR	T. BROWN	K. LEAVERS	F. BYRD
9		J. HOWARD	BAKER	J. DEVORE	P. CARPON		PHILLIPS	E. WISE	A. AGNEW	N. HUNT	A. LEAVERS	T. SMITH
10		WILLIAMS	J. KEIR	J. GUMP	M.R. SHIPE	PHILLIPS	ALLISON	H. ALLISON	E. AGNEW	R. MILLER	G. STAHL	EMERICK
11		J. WILLIAMS	TRIELMAN	SUFFILL	J.A. SHIPE	J. PHILLIPS R. PHILLIPS	ALLISON	D. KLINE	J. ANDERSON	G. TAYLOR J. AMMON	F. AMMON	
12	ROSEBERRY	K. LANDREY	P. TRIELMAN	S. SUFFILL	W. MARTIN	S. PACKER PARKER	F. WILLHOPT	T. COLEMAN	E. GALVINE	M. CAMPBELL	M. COLE	E. WESTON
13	ROSEBERRY	A. LANDREY	S. PORRER	A. KOPP A. KOPP	C. GRATZ	C. PARKER	G. WHITE	McWHORTER	M. WHEELER	A. PARSONS	T. ZAKOVSKY	G. WESTON
14		C. FRIEND	PORRER	DEMARANVILLE KOPP KOPP	A. GRATZ	A. KILEY	A. GRUSSER	C. McWHORTER	J. WHEELER	P. HOGAN	E. VALENTINE	E. HALL
15	S. VORHEES	GRAY	A. POROMSKI McMILLEN	W. DERR	D. GRATZ	P. JEREMINE	JULIANO		BARR	C. VARNER	R. SMITH	BILLINGS
16	H. VOORHEES	W.E. GRAY	W.E. McMILLEN	J. FAGAN	E. BARNET	J. DICKINSON	F. JULIANO	L. HILL	R. BARR	S. WRIGHT	A. RENSHAW	J. BILLINGS
17	WHITE	C. CHRISTY F. CHRISTY	M. ALLEN	C. PERRINE	W. TOPPING	A. McQUAY			M. BRADFORD	G. YODERS	R. McCOMBS	C. NYSTROM
18	E. WHITE	CHRISTY	H. ALLEN	H. PERRINE	C. KNOX C. KNOX	S. BARRETT	H. HULLIKEN	A. NEFF J. DANIELS H. BRADFORD	P. FORDYCE	J. STICKLES I. McFALL	McMULLEN L. HUFFORD	T. GILBERT H. EMERICK
19	P. JOHNSON	A. NICHOLSON	J. BROWNLEE	P. ZEDIKER	I. McCARTNEY	G. STAHL	J. KIOZYZANEK	T. HANNA W. BRIGGS	J. FORDYCE	J. STICKLES	A. LOCY	E. AMOS
20	C. JOHNSON	J. NICHOLSON	BROWNLEE	J. ZEDIKER	B. McCARTNEY	M. BRIGGS	A. WOLOKYS	R. MAZE	O. ENGLE	F. LINDLEY	H. EARLIWINE	AMOS
21	E. PAUL	KNESTRICK	C. WRIGHT	CONRAD	M. SPEASE	C. COX	W. WOLKOYS	W. PORTER R. DIXON		R. KNESTRICK	C. BAKER	G. BARNEY
22	H. PAUL	D. KNESTRICK	R. WRIGHT	M. CONRAD B.R. MAUCHLINE	WHITEMAN A. ACHESON	COX	T. SATUTA	R. EMERICK W. PATT M. ANDERSON	D. McGARA	S. FOX	E. NORDSTROM FETHERLIN	P. HALLAM
23	E. MOULTON	LONG	DEBOLT E. BIRD	A. SEAMAN	S. DORCHAH	M. McLARREN	S. MACK S. GATTEN	E. EMERICK	KINNAN	W. HARTLEY	NORDSTROM	HALLAM
24	M. CARTEN	J. LONG	R. BIRD	LISTON	J. KNESTRICK	J. WILSON	A. WIEDMAN	I. POWERS	W. KINNAN	R. NIXON	B. JONES	HALLAM
25	VANDERSON		Y. THOMPSON	J.A. LISTON	DEWITT	D. McCUTCHEON	R. WRIGHT	POWERS	ASHCROFT	F. CLEMENS	E. JONES JONES	M. COMER
26	MINDIEINO		R. LITTELL	C. GALLOWAY C. GALLOWAY	I. DEWITT	McCUTCHEON	J. SCOTT	J. YATER H. ASHCROFT	R. WAGNER	R. WAGNER	C. BOSWELL	KOPP
27	F. MINDIEINO	J. PABST	L. ANDERSON A. ANDERSON	J. GALLOWAY	A. KUBECKIN	L. MOUNTS	J. LEBARRE	M. McDONALD		R. MECKS	M. GARY E. GARY	A. KOPP
28	A. BOARD	E. MAWHINNEY	W. DAUGHERTY	I. CLUTTER I. CLUTTER	E. BAJO	R. DAUGHERTY	G. WYLAND	O. WADE	HAMILTON	TAYLOR	D. GARY	FRAKES
29	M. MESTA	C. MAWHINNEY	T. OLIVERIO	H. CLUTTER	J. MAIN	S. KATREEB	M. ALLENDER		K. HAMILTON	H. TAYLOR		Z. FRAKES
30	H. MESTA	J. RENNER	S. STAHL	F. STEWART A. STEWART		KATREEB	T. McNEELY	M. LOUGHMAN	M. ABEL	L. MARTIN	D. RITCHESON	R. ULLOM
31		RENNER	F. HECKMAN		J. LEONARD	W. HALL	J. BECK	W. LOUGHMAN	E. LACOMB	MARTIN	E. McMOLLEN	C. ULLOM
32			E. McILROY	E. ANDERSON		E. SICKLES	V. GALANOS	N. MUNKIN	E. CHINCHALLA			M. CRILE
33	S. BUCHANAN	E. VEIOCH	L. EWING	ANDERSON	F. POWELL	W. ALLEN	G. HUTTER	W. WILLIAMS M. FRIEND		McFALL	A. IRWIN	CRILE
34	A. BUCHANAN	MRS. EVANS	J. EWING	C. LEVATO	R. STEWART	B. ALLEN	C. PHILLIPS	D. WEIMER	RIGGS	O. HALL	J. IRWIN	M. BLAKE
35	F. GLEASON	A. EVANS		P. LEVATO	W. KEELING	L. PATTERSON	W. DAVIS	H. MITCHELL	H. ANDERSON	MADDORK	ROWE	
36	B. ENOCH	ROMANO G. CANTARA	WESTFALL	M. CRAIG	J. BROWN		S. JONES	MITCHELL	W. ANDERSON	W. MADDORK	G. ROWE GARNER	D. CONKLIN
37	ENOCH	E. EWING W. CANTARA		G. CRAIG	H. MILLER	J. SLACK	W. JONES	L. CLUTTER		M. HEWITT		M. CONKLIN
38		H. JAMES	E. LEYSHAW	MRS. W. BELCASTRO	E. McKAY	W. DECKER	G. POLITES		W. CLUTTER	M. HEWITT	GARNER	P. DILLIE
39		A. McCARTNEY		BELCASTRO W. BELCASTRO	D. MILLER	J. KUNGE	C. RODOCHER	M. HARRINGTON	N. RISER	M. YODERS		DILLIE
40	RILEY	E. McCARTNEY	C. HIGGINS	H. BIRCH	M. HUTSON				G. RISER	BEECH	BREWER	O. DAVIS
41	RILEY	N. BEDILLION		J. BIRCH	E. LYON		M. HUTTER	S. ZIMMERMAN B. CARPENTER		J. BEECH	J. BREWER	M. DAVIS
42	MARTIN	H. BEDILLION	R. YOUNG	T. McCLOSKEY	A. SICKLE	A. BREESE	C. HUTTER			BEECH	BREWER	A. SKRABSKI
43	C. MARTIN	SCHRADER	D. SCOTT	W. McCLOSKEY	W. PHILLIPS	P. GREENE	T. ADAMS	A. SCHULTS		E. GRAY	COMFORTI	
44	WALES	D. SCHRADER	M. KING		MRS. G. PHILLIPS	R. CREZO	E. GREEN	T. SCHULTS	S. STAHL	A. GRAY	J. COMFORTI	M. RHODES
45		S. SNYDER	P. KING	M. MORRIS	G. PETERSON	S. WILSON	P. GARRETT	M. CARPENTER	A. NICHOLS E. McDOWELL	E. McDOWELL	W. GARDNER	RHODES
		J. SNYDER	R. BROWN	J. MORRIS	F. WIDLUND	C. REID	J. GARRETT	E. MULL J. CARPENTER		McDOWELL	G. MITCHELL	
		T. DUVALL	G. BROWN	A. HULT	E. McCARTNEY	J.F. HALL	F. RAKAS	C. OWENS J. ERZEN		N. ALLEN	R. ALLEN	
		G. BOARDLEY	M. ZERVAS	A. HULT	E. McCARTNEY	MAZE	I. TAYLOR	W. POWELL	J. BEATTY	N. MARKER	M. RENKO	
	W. BOARDLEY		S. THOMPSON	F. CHRISTMAN		J. PETTIT	J. SIBURT	DANIELS	E. BEATTY	L. MARKER	F. RENKO	
		J. THOMPSON			A. PLANTS W. PLANTS	W. WISE	. HAYES	I. HUNT		J. KNESTRICK	W. BARRETT	
		R. STAHL				B. FRIEND	M. GRAY	R. HUNT	A. THOMAS	G. HIGHBERGER	C. BARRETT	
				M. BARRETT	R. GRIM	T. JONES	E. JONES	B. DESMONDE	A. THOMAS	F. HIGHBERGER		
				G. BARRETT	L. GRIM	W. JONES	MRS. CAREY	M. DESMONDE	S. McDONALD			
					R. GRIM	M. EAKIN	J. CAREY		W. McDONALD			

BLOCK 18

BLOCK 19

J	I	H	G	F	E	D	C	B	A
60 H. COREY	60 G. KING	60 W. CURRY	60 D. SUTTON	60 J. WASACZ	60 E. HALL	60 BAMON	60 SKANTOR	60 C. KING	60
59 M. CASPER	59 J. TREVENA	59 R. BARBOSKI	59 M. MILLER	59 T. TRAVENA	59 A. RUSCHELL	59 L. MALATA	59 CANDERSON	59 H. ALLEN	59 L. JEPSON
58 RULLOM	58 A. VARNER	58 A. LUTHERAN	58 A. WISE	58 R. BROWN	58 CALLEN	58 W. THOMAS	58 F. FREY	58 CALLEN	58 M. GATES
57 S. BUNNELL	57 P. BABISH	57 H. RINGER	57 T. NEICH	57 P. FARNSWORTH	57 A. BICE	E. O'BRYAN 57 R. MARSHALL	57 H. DEVENNEY	57 L. CLARK	57 C. HICKS
56 R. BATSON	56 R. MARTIN	56 R. ROMANO	56 E. HOWARD	56 D. BERGIN	56 C. FEKER	56 H. HEMMINGWAY	56 H. FOX	56 J. SCOTT	56 E. BOARDLEY
55 L. CARROLL	55 D. TURNER	55 M. FORDYCE	55 F. JUNKO	55 J. DAUGHERTY	55 C. RUSH	55 S. WISE	55 S. GLARUIS	55 K. IRWIN	55 G. SCHOLTEN
54 R. THOMAS	54 D. BONGIVAND	54 W. McCOY	54 L. BERROTT	54 P. DESMOND	54 P. DERINEUS	54 M. MILLER	54 H. MILLER	54 N. SMALL	54 E. ROUPE
53 A. HART	53 A. RIGGANS	53 D. TRIVERI	53 R. SHEETS	53 J. JONES	53 E. DICKINSON	53 F. HERRON	53 L. WHITE	53 H. SARTOSKY	53 W. MARSHALL
52 L. KING	52 M. BRICK	52 F. MURNICK	52 J. PLUTE	52 L. DAUGHERTY	52 E. SNYDER	52 E. SMITH	52 C. GOODING	52 T. BICE	52 L. ADAMS
51 F. JOHNSON	51 J. McMASTER	51 A. KING	51 J. AYERS	A. VEIBEK 51 A. VENCK	51 J. GUYON	51 M. SILAR	51 L. McKAY	51 F. ODOVICH	51 J. HORNER
50 S. DAILEY	50 V. CROWE	50 S. LOBB	50 G. FRITSCHLE	50 T. FRYE	50 S. RENZ	50 H. GHRIEST	50 H. JAMES	50 T. KNOX	50 H. DAVIS
49 C. CAHILL	49 G. MACIK	49 J. ALLENDER	49 H. CURR	L.B. MILLER 49 R. KARR	49 W. STEWART	49 R. KARR	49 M. STICKLES	49 V. LUCAS	E. BECK 49 G. AVERY
48 E. RITCHIE	48 R. GARBINSKI	48 C. MARTIN	48 J. MALISH	48 M. McBRIDE	48 E. ALLEN	48 T. TOMAZIN	48 S. MILLER	48 C. HINEBAUGH	48 C. BISSETT
47 G. MOSSBURG	47 H. CREOCH	47 W. FORD	47 L. SICKLE	47 M. MANDICH	47 J. SKRLAS	47 B. ANDY	47 F. PUGH	47 H. POLLOCK	47 C. WAGNER
46 M. BOYKO	46 M. WHEELER	46 W. LYONS	46 H. BATSON	46 J. KOSOVICH	46 N. ALLEN	46 H. MICHOTTE	46 C. HECTOR	46 M. POPOVICH	46 F. SPINNER
45	45 M. HARRIS	SALISBURY 45 C. SALISBURY	LOEY MF-2 45 W. DUNCAN	45 J. AMMON	45 E. PHILLIPS	45 H. SCHOLTEN	45 F. KACZINAR	45 WOLXON	45 V. GUBERT
44 G. PELKY	44 J. GILBERT	44 R. POUNDS	44 R. POLAND	44 H. ANDERSON	44 W. GLOVER	44 S. BENNETT	44 RING	44 D. FLYNN	44 J. GILBERT
43 H. LINSLEY	43 M. FLORIDA	43 S. PERRINO	43 H. McCREA	43 M. GRUDIA	43 MARA ZOWSKI	T. TOMAZIN 43 R. MOURER	43 S. JOHNSTON	43 M. WHITE	43 H. McLAUGHLIN
42 J. POLAND	42	42 C. RANDOLPH	42 W. SELWAY	42 E. ROBERTS	E. ROBERTS 42 J. LINDLEY	A. PRATT 42 B. PRATT	42 D. LENNOX	42 J. BEZAK	42 J. BICK
41 M. WALKER	41 H. LOAN	41 S. BRADEN	41 W. ALLEN	41 J. RITCHIE	41 C. BURGESS	41 L. NANGLE	41 V. BAINBRIDGE	41 L. PLOTT	41 G. BAYSINGER
40 J. SIMPSON	40 M. SHERMAN	40 M. ABRAHAM	40 F. EHNERT	40 J. NEFF	40 S. McBRATNEY	40 G. OLENAK	40 B. KLEID	40 F. STEMPLE	40 S. KALARINIK
39 R. DUNCAN	39 L. SAMS	39 V. HUTSON	39 E. MORRIS	39 T. BURGH	39 A. ZNKO	39 N. McCOMBS	39 F. McCRACKEN	39 C. WHITEMAN	39 E. SCOTT
38 J. LYCETT	38 S. ANDY	38 S. BEACH	38 S. HOWARD	38 F. TAROLLIS	38 G. BELLENES	38 J. LYONS	38 J. FISHER	38 S. VERSO	38 H. SAYRE
37 C. QUEEN	37 M. MALONEY	37 E. STEVENS	37 A. SCHOLETOKY	37 L. CHIABERTO	37 F. MARRIS	37 J. LITZ	37 J. HOWARD	37 W. FORD	37 T. MULLEN
36 H. KARR	36 L. MITCHELL	36 U. SHRIVER	36 E. MITCHELL	36 J. KETTLER	36 J. HORNYAK	36 C. ELLIOTT	36 N. EARLEY	36 C. DROZI	36 T. BIELHY
35 C. KELLEY	35 R. HERROW	35 A. TALLARICO	35 M. BELCASTRO	35 C. SPEASE	35 M. THELEN	35 M. HEWITT	35 W. McCOMBS	35 W.L. LEWELLYN	35 M. SEIBERT
34 A. NOWICKI	34 J. KLINSZA	34 M. POUNDS	34 W. McKEE	34 E. PORTER	34 E. CRAIG	34 W. JOHNSON	34 N. MATSIK	34 M. BAYNE	34 P. CARTER
33 B. SANTEK	33 L. JONES	33 G. COLE	J. RUSH 33 E. RUSH	33 W. WILSON	33 M. ROGAN	33 H. NESTER	33 D. THOMAS	33 C. PRENTICE	33 S. GARRETT
32 J. MAMIC	32 W. MORRIS	32 M. RINKO	32 P. YORK	32 J. PATTERSON	32 P. MANCINA	32 W. DOUGLAS	K. ELLIS 32 A. DANKOWSKY	32 D. ULLOM	32 C. BARNEY
31 E. SALADA	31 P. KUBACKO	31 J. ALEXANDER	31 C. PERTS	31 E. CROXTON	31 J. CARPENTER	31 M. POPVICH	31 E. EVANS	31 H. SHAW	31 L. KRUEGER
30 W. BARTO	30 M. TREVENA	30 V. WILSON	30 S. SANTO	30 B. LINDLEY	30 H. DENNMAN	30 J. HUNT	30 C. TOLAND	30 S. TOROK	30 P. HUTEFF
29 G. DEMCHILLA	29 G. BROWN	29 A. POWELL	29 N. MEYER	29 C. BOYD	29 F. KLINZLITG	29 J. GRUNDY	29 L. ARNOLD	29 D. HECK	29 H. CARPENTER
28 G. SCOTT	D. McCLELLAND-INF 28 CLEMENS	28 BURSO	28 O. KIMMINS	28 A. DICKEY	28 D. FINDLEY	28 E. FORD	28 D. KELSO	28 M. MUNCHIC	28 N. WATSON
27 O. FLORIDA	27 J. HART	F. FREEMAN 27 E. DATUSIEK	27 E. NIXON	MAIN-INF. 27 L. BOOTH	27 C. McKENNA	27 J. BATSON	27 A. ALEXANDER	27 PELAFFEY	27 A. BLACKMAN
26 J. THOMAS	26 M. ROUX	26 J. KERR	26 A. KOPTA	26 J. HANDERS	26 M. MILLER	26 E. PINKERTON	26 T. HIGGINS	26 H. SADOFY	26
25 M. SIBERT	25	C. FRYE 25 C. DOLLISH	V. RUSH 25 C. RUSH	25 F. SPROWLS	T. AMBROSE 25 E. REDLINGER	25 A. SCHROEDER	25 S. CAPKO	25 P. ZOTNI	25
24 C. POUNDS	24 L. HAMMOND	24 D. DAVIES	24 H. ALLEN	24 D. FINDLEY	24 J. KEDRICK	24 M. PETRO	24 F. YOUNG	24 F. BURGH	24 R. COOLS
23 S. STAUFFER	23 O. VONBERG	23 A. GORMLY	23 J. PRESTON	23 I. POWELL	23 M. MARCO	23 E. POLAND	23 T. SELBICK	23 L. BUNCH	
M. DEMPSEY 22 J. BIER	22 A. MULL	22 V. EDLE	22 F. PETERSON	22 H. GILES	22 H. LINDLEY	22 M. ADAMS	22	22 L. SHAW	
21 S. MEEKS	21 M. HOWARD	21 A. LEEPER	21 H. WALTONS	21 J. BEDDOW	21 A. TRADER	21 J. GEORGE	21	21	
20 V. HIGGINS	20 E. WYLAND	20 C. BARR	20 R. COX	20 J. WOOLSLAYER	20 N. CROWE	20 P. COX	20 L. McCARTNEY	20	
19 M. COOK	19 F. KING	E. MILLER 19 A. LEEPER	19 G. ANDERSON	T. FRY H. HARTZOG 19 J. AMMON	C. MORRIS 19 T. AMBROSE	19 C. WISNICSKI	19 L. McCARTNEY		
18 E. JONES	18 V. ZEMBO	18 J. NEIL	18 N. BEACH	18 J. NUZUM	18 R. SMITH	18 P. HOLMAN	18		
17 B. FLOWERS	17 M. KAMINSKY	17 C. SCHRIVER	17 L. SIX	17 M. SCHWERING	17 E. JOHNSON	17 W. RODGERS			
CORBLY 16 D. CORBLY	16 L. FRAZEE	16 C. SPANOGLE	16 N. JONES	16 W. CROWE	16 W. BRADFORD	16 H. RODGERS			
15 S. KALIEL	15 J. THOMPSON	15 M. ALEXANDER	15 E. MITCHELL	15 N. WARMOS	15 F. PISZCZELS	15			
14 H. BAKER	14 R. TRUAX	14 J. BELCHER	14 M. CHRISTMAN	14 J. JONES	TAYLOR 14 D. PORTER				
13 A. BELLICK	13 F. DAY	13 M. KARR	13 A. BELCHER	13 L. LEAVERS	13 C. BERDINE				
12 G. MUNKIGS	12 C. McCLELLAND	12 A. ROSS	12 CLYDE HALE	12 C. SIBERT	12				
11 L. GEORGE	11 L. MOSSBURG	11 E. HOLMES	11 V. MONTGOMERY	11 J. KAWA					
10 J. STAVROULAKIS	10 W. BAKER	10 F. HASENPORT	10 J. GOUGH	10					
9 J. WALTZ	9 E. SIMPSON	9 M. ROBBINS	9 K. FREDERICKSON	9					
8 J. CHOLIS	8 E. BARTH	8 L. CAGE	8 W. SNYDER						
7 P. JURKICORZ	7 E. COWNERS	7 E. DRAKE	7 C. MIGLEO						
6 R. TEDESCI	6 O. RODENHAUSER	6 P. PORTER	6						
5	5 E.H. LUMA	5							
4	4 M. REYNARD	4 M. REYNARD							
3	3 L. MAURER	3							
2	2 H. NOVOGAHDAE								
1	1								

J	—	H	G	F	E	D	C	B	A
				51	51	51 F. KNOX			
			50 TAYLOR	50 E. WILLIAMS	50 E. TALBOT	50 G.E. LOADIS			
		49 L. HARDING	49 A. MOORE	G. McBANE 49 T. MASON	M. BERRY 49 J. CETERO	49 G. McPHERSON	49		
		48 A. WISE	48 D. HUGHES	48 D. KERR	48 V. BLACKA S. SAVIK	48 S. WISEMAN	48 B. MOORE		
		47 E. LUCY	47 R. HAUGHT	47 C. PEARSON	47 W. PARKINSON	47 V. XENOS	47 H. ADAMAC		
	46	46 A. SPICER	46 A. AUGIER	46 J. LIPAY	46	46 G. GHEEN	46 G. ECKERT	46	
	45	45 C. PETEL	45 A. WATSULA	45 L. RUSCELLO	45 K. VEZIE	45 F. MOORE	45 W. PATTERSON	45 M. MARTIN	
	44	44 J. PAKUTA	44 J. CZOTKA	44 M. ROBERTS	44 C. RAUER	44 J. RONEY	44 M. AMON	44 M. SICKLES	
	43	43 S. RANDOLPH	43 A. GEORGE	43 E. WEIMER	43 G. SALAMONC	43	43 R. GLOVER	43	
42	42	G. LARSOR 42 H. STICKLES	42	42	42 S. WINKLER	42 E. KERR	42 A. KACTO	42 J. MOORE	42 PLASKINA
41	41	41 W. FOX	41 D. MOORE	41 B. COOKE	41 R. JENKINS	41 N. ZIGMONT	41 H. THOMAS	41	M. POLISKA 41 J. GREEN
40 GRAY	40	A. HOLMES 40 D. WRIGHT	40 H. LEWIS	40 S. DEEMS	40 W. WARE	40 W. WRIGHT	H. THOMAS 40 S. McBRATNEY	40 K. SEWASKY	L. PORTER 40 HENGLE
39 HEMELRICK	39	M. BACKNAR 39 J. KIESTER	39 M. FARLEY	39 W. MANDICH	39 M. KISTNER	39 E. WELCH	39 S. HIGGINBOTHER	39 L. NORES	I. ROGERS 39 M. WILLIAMS
38 E. HEMELRICK	38 AUGER	38 W. THOMPSON	38 L. MARTIN	38 R. HARDIE	38 C. FOX	38 E. TAYLOR	38 M. BAER	H. CALLAHAN 38 K. VALENTINO	38 M. LYTLE
37 C. GRACE	37 C. CAGE	37 H. ALLEN	37 J. COMFORT	37 G. FURBEE	37 D. PINKERTON	37 E. RUSH	37 M. MYERS	37 J. SOKO	37 M. LYTLE
36 C. PALMER	36 L. SUTVARIE	36 A. FONNER	36 B. FUMARA	36 R. EVANS	36 C. AMOS	36 M. CLOUNER	36 C. CIMACCIA	36 G. WISSLER	36 C. MEEKS
35 E. ASHMORE	35 D. BELL SR.	35 G. COSGRAY	35 R. BECKUS	35 E. WEIMER	35 J. DENNISON	35 T. EGERTON	35 P. LEFKO	35 E. HOKE	35 G. CLARK
34 S. PALMER	34 H. MANGROM	34 M. PHILLIPS	34 W. BARNES	34 A. BOGAN	34 M. PINKERTON	34 A. BENNETT	34 E. McCANN	34 M. SUPAN	34
33 C. RENNER	33 H. McANAY	33 I. URSO	33 W. WILLIAMS	33 S. SCHELETSKY	33 W. RUSH	33 A. OCHKO	33 J. MARIS	33 J. FULLER	33 M. WILSON
32 C. GUMP	32 J. MULL	32 M. KEENER	32 C. CURICO	32 D. BILBY	32 L. DEWMAN	32 H. BEHNER	32 J. ELLIS	32 B. YAROS	32 C. HEEK
31 V. MATONI	31 B. ROWER	31 L. GRAY	31 J. GOODRICH	31 J. KWASNIK	31 M. CALDWELL	31 A. DEPHILIPP	31 T. LILLEY	31 K. PAULINE	31 W. CLUTTER
30 M. DANLEY	30 C. BROOKS	30 J. CARROLL	30 B. WILES	30 J. SABO	30 J. MORRIS	30 H. ARMOR	30 C. WILES	30 J. DOIDGE	30 F. BIELEN
29 J. CLARK	29 S. McCARTNEY	29 J. THOMAS	29 P. STILWELL	29 J. PRATTON	29 A. DUNCAN	29 A. MEDICH	G. GALLAGHER 29 A. RANDOLPH	29 D. ELLIS	29 P. JASWA
28 J. THOMAS	28 C. MIGLEO	28 C. DRURY	28 C. OZVALTH	28 I. PETHEL	28 D. BOARDLY	28 C. BERNET	28 S. RUSSELL	28 T. MURRAY	28 S. TRESIDDER
27 R. GASTON	27 W. PELLOY	27 D. DURBIN	27 B. RITCHIE	27 J. CARRICO	27 R. CAIN	27 F. CINDRICH	27 A. McFALL	27 P. MINNIES	27 S. WISE
26 P. HART	26 W. FILBY	C. PEARSON 26 H. PEARSON	26 C. EVANS	26 E. HAINES	26 T. NAGLOSKY	26 R. HOOVER	26 C. BERRY	26 T. O'NEIL	26 L. HEWITT
25 F. BLAKO	25 C. SAWTELLE	25 J. WRIGHT	25 D. WISE	25 D. SILCOTT	25 M. GROSLEY	25 W. WISEMAN	25 M. CALDWELL	25 J. PRATTON	25 W. KLOGUS
24 J. BILLINGS	24 E. STRICKLIN	24 A. CECCHINE	24 W. FOGLE	24 D. SHILLING	N. MOSIER 24 L. MURRAY	24 V. SARIOSK	24 M. RUSH	24 M. PAULINE	24 A. ROE
23 R. JOHNSON	23 A. DERR	23 A. GREEN	23 C. RUTAN	23 S. SCOTT	23 G. EVANS	23 F. ANTILL	23 R. AMMON	23 L. SYLVESTER	23 R. HART
D. MOORE 22 A. MOORE	22 E. CECCHINE	22 T. KURRIS	22 D. RUTAN	22 H. HOUSTON	22 T. MINNIES	22 V. PROWITT	22 H. RUCK	22 I. WELSH	22 C. VALENTINO
21 E. MAXWELL	21 I. YEAGER	21 R. McDANIEL	21 F. CHAPMAN	21 J. BEBOUT	21 P. CLARK	21 J. SIMMS	21 L. BARRETT	21 E. MEEKS	21 J. MAIEKS
20 V. LUCY	20 M. REESE	20 V. PANEK	20 D. HUPP	F. ROBERTS 20 C. MORGAN	20 J. WILSON	20 W. McCOY	20 N. POPOVICH	20 I. WESTLUND	20 D. HOGGINS
J. TURNEY 19 C. McADAMS	19 M. MARQUIS	19 C. FRAIKES	19 J. PATTERSON	19 A. HATHAWAY	19 M. TUNKO	19 C. RUSH	19 C. PETERSON	19 J. MILLER	19 A. McCLELLAND
P. MARTIN 18 J. FLUHARTY	18 A. MATTOY	18 J. MARTIN	W. BLACK 18 J. GARNER	18 J. RAITNER	18 H. CHURCH	18 H. McCLOSKY	18 W. SHERMAN	18 J. GARNER	18 L. HAMPTON
17 H. WALKER	17 H. SARTOSKI	17 W. WATTERS	17 C. ALLEN	17 B. McCOY	17 K. KNESTRICK	17 M. FISHER	17 B. JOSEPH	17 H. LILLICO	17 M. DESMOND
16 G. HICKS	16 G. HARRIS	16 J. SHAFFER	16 H. SHEWAN	16 PULERICH	J. SMITH 16 E. BOYD	16 H. MARTIN	16 S. RUSH	16 E. SWART	16 V. HILDEBRAND
15 M. THOMPSON	15 M. CAIN	15 J. NEWMAN	15 W. WHEE	15 D. DENMAN	15 S. McCOMBS	15 H. ELBY	15 M. McMASTERS	15 M. HOPP	15 C. OGNAY
14 R. DELBROOKE	14 J. BIRD	14 J. DUNCAN	14 B. EVANS	14 M. VORHES	14 J. LOUGHMAN	14 K. RASEL	14 G. VORHES	14 J. GERETS	14 H. PETTIT
13 M. SAMBROSKY	13 S. MEEKS	13 E. ENGOTT	13 J. MALIND	13 W. LANE	13 S. LYONS	13 F. WOJELAK	13 C. DANLEY	13 C. GRUMICK	13 E. POLAND
R. CLARK 12 E. JOHNS	12 J. PETRAK	12 J. McMULLEN	12 W. COLE	12 B. REMALEY	12 J. SHILLIFF	12 G. STILENGOL	12 S. GEORGE	12 M. STEPHENSTON	12 N. McELRAVY
11 D. STETSON	11 C. McMULLEN	P. CURRY S. CURRY II T. CURRY	11 D. MOORE	11 A. TASSONE	11 W. PERTS	11 F. VILLERS	11 M. DANLEY	11 W. LLOYD	11 S. SHIFFLETT
10 J. CROSLEY	10 J. GUDLIN	10 O. HARTON	10 P. ROMANEK	10 J. BURGARD	10 E. GROVE	10 W. BIRD	D. ROBERTS 10 L. LEVENTIS	10 L. OBERSH	10 H. HARRIS
9 R. HERBUREAU	9 V. WRIGHT	9 M. DUNCAN	9 W. HARTMAN	9 A. ALEXANDER	9 M. PAXTON	9 S. MOSIER	9 E. ENGLE	S. FOX 9 J. TAYLOR	9 M. DROP
8 S. MIHALLIE	8 J. BATESON	8 F. HAYES	8 B. GOODING	8	8 F. FOFLYGEN	8 J. WALLACE	8 R. BROWN	8 S. ZURAS	8 E. GIZZONE
7 B. HUGHES	7 G. GRAY	7 H. SCHULTZ	7 B. DETRICK	7 E. BURRIDGE	7 F. BILBY	7 T. CAGE	7 J. PATRUS	7 P. SEVITNICKY	7 G. PULKOSKI
6 T. GROVE	6 M. FLUHARTY	6 E. WALLACE	6 J. WILSON	6 J. CROTHERS	6 L. LEPORATTI	6 R. THOMPSON	6 J. HAYES	6 J. WELSH	6 A. BIER
5 M. CASPERT	5 T. ORMAN	5 A. YOUNG	5 J. SICKLES	5 B. PULKOWSKI	5 W. MILLER	5 R. DEVON	5 M. FETHERLIN	5 L. CARTER	5 M. COLE
4 L. FAST	4 R. GREER	4 C. HACIC	4 B. BLAKESLEE	4 C. MERGEN	4 G. CASTO	4 P. POFOPISHIO	4 R. MEEK	4 J. ASHMORE	4 B. JEPSON
3 J. MODEL	3 I. ROSE	3 M. BUSH	3 A. COOPER	3	3 E. DUBINA	3 L. ROOD	3 R. LEWIS	3 G. PIERCE	3 C. RUSH
2 J. LYCETT	2 D. EAMES	2 E. KEHN	2 L. NEEHOUSE	2 G. REMALEY	2 N. DUBINA	2 T. EILAND	2 R. HYDE	2 T. BARNHART	2 T. FERRARO
1 J. CZOTKA	1	1 P. PAPA	1 J. WARD	1 J. HOLMES	1 F. PETTIT	1 M. GRAHAM	1 H. REEVES	1	1 G. WOLF

BLOCK 20

J	I	H	G	F	E	D	C	B	A
				Zentz 27	Chambers 27	Hilton 27	Pacella 34	A. Bier 34	Schurr 30
			27	Mrock 26	Cox 26	Fox 26	Bell 33	E. Patterson 33	Gheen 28
			McDaniel 25	Boyd 25	Rood 25	Randolph JR 25	L. Jones 32	Marshall 32	Martin 27
			Jenkins 24	Boyd 24	Rood 24	Dorothy Randolph 24	Goffried 31	Dunn 31	Patterson 26
			Collins 23 / Ward 23	Fields 23	Wiseman 23	Wheeler 23	F. Minnis 30	Thomas 30	Anderson 25
		Jordan 22	Jenkins 22	Maloy 22	Putorti 22	Boyd 22	N. Bird 29	Caldwell 29	
		Jordan 21	Jenkins 21	Findling 21	Malik 21	Feuer Nagel 21	H. Cunningham 28	O. Wilson 28	Holmes 24
		Jordan 20	Duncan 20	Porter 20	Dickey 20	Gray 20	C. Curry 27	M. Anderson 27	Jones 23
		Jordan 19	Philips 19	Zediker 19	Tucker 19	Wolfe 19	M. Klotko 26	M. Stevenson 26	Kelley 22
		Dillie 18	McAllister 18	Zediker 18	Rodgers 18	Barclay / Murr 18	E. Strickling 25	M. Steffik 25	
		Evans 17	Harps 17	Pignell 17	Mitchell 17	Matewski 17	J. Comfort 24	L. Williams 24	Taylor 21
		Morris 16	McCartney 16	Johnston Sr. 16	Mitchell 16	Pettit 16	L. Morris 23	"Lost Space" 23	Taylor 20
		Garrett 15	McCartney 15	Arent 15	Hello 15	Spease 15	J. Gallo 22	Jackson 22	
		Connors for Fretz 14	Griffin 14	Duncan 14	Hello 14	Spease 14	G. Bortram 21	Riley 21	Blake 19
		Levak 13	Lowe 13	Porter 13	Mitchell 13	Duncan 13	F. Villers 20	Moenich 20	McGary 18
	Stinnette 12	Dailey 12	Lowe 12	Steuernagel 12	Mitchell 12	Herman Rush 12	M. A. Scott 19	Plants 19	
	Dailey 11	Dailey 11	miller 11	Evans 11	Mitchell 11	Mueller 11	Sylvestro 18	Bunnell 18	McGary 17
	Stinnette 10	Dailey / Robinson 10	miller 10	Safran 10	Mack 10	Eva Mays 10	Ward 17	Cargene 17	Black 16
		Dailey / Robinson 9	Prevost 9	Guy 9	McFall 9	Martha Gallo 9	"Lost Space" 16	Denman 16	Siburt 15
		Byrne 8	Byrne 8	Guy 8	McFall 8	Anthony Berry 8	Mason 15	Harmon 15	Hitchew 14
		Byrne 7	Byrne 7	Hannen 7	Gold 7	Parker 7	John Mason 14	Lost Space 14	Archibald 13
		Byrne 6	Byrne 6	Hannen 6	Kuhn 6	Fisher 6	Mason 13	Martin 13	Denman 12
			Maloy 5	Andrew 5	Hays 5	Harris 5	Ackerman 12	L. Coburn 12	
		Cole 4	Cole 4		Newland 4	Poland 4	Ackerman 11	M. Stafford 11	Denman 11
		Cole 3	Cole 3	Tulock 3	Trusel 3	McMaster (Cardeno) 3	Ritchie 10	L. Lewis 10	Kubacka 10
		Ross 2	Poland 2	Kennedy 2	Lindley / A. Scott 2	Garbinski 2	Van Riper 9	A. Lewis 9	Pulkowski 9
		Newland 1	Poland 1	Kennedy 1	Lindley / A. Scott 1	Garbinski 1	"Lost Space" 8	"Lost Space" 8	Pulkowski 8
						Williams 2	Wheeler 3	Suthard 2	McNamara 2
						Beal 1	M. Sampson 2	Lank 1	M. Wise 1

Block 23


Read

I H G F E D C B A

H	G	F	E	D	C	B	A	
		Mitchell		BOAC	RUSCELLO	DUDLEY	HUTCHINSON	1
				ROUX	RUSCELLO	DENMAN	WISE	2
				ROUX	BLACK	DENMAN	JOHANNS	3
						TAYLOR (HUGHES)	BACQUE	4
						Hold w/o/m Justin TAYLOR	BACQUE	5
					IRIS REUSCH	Hold w/o/m Justin TAYLOR	NORTHCUT	6
					HOLD BAMBI REUSCH	REUSCH	JOHNSON	7
						DAILEY	MALIK	8
					SHUBA (SANTEC)	SANTEK	MALIK	9
					SANTEK	VIZZA	SHRIVER	10
					Hold Hold Hannah 9/12/20	DENMAN	KALICH	11
						WALKER	KALICH	12
						ROBLE	REED	13
						ROBLE	HARTLEY	14
						SHAFFER	TERRELL	15
						SHAFFER/ JENKINS	HOLD MITCHELL	16
						~~SHAFFER~~/ JENKINS	BURGINS	17
					WATSON		BURGINS	18
					REED		Blackwell	19
						Hold BOTH AKs	AKU	20
							CHANDLER	21
							SWESKY	22
							WEST	23
					HADLOCK		McDAID	24
							SANTEK	25
							HAYES	26
							GUEST	27
							WHITLOCK	28
							WHITLOCK	29
							KISKADDEN	30
							DEMPSTER	32
							McGill	33
							McGill	34
							BROWN	35
								36
							RIDEOUT	37
						Hold Hold WISE		38
						Hold WISE	WISE	39
						Hold Hold WISE		40
							WHEELER	41
								42
								43
								44
								45

Road

BLOCK 24

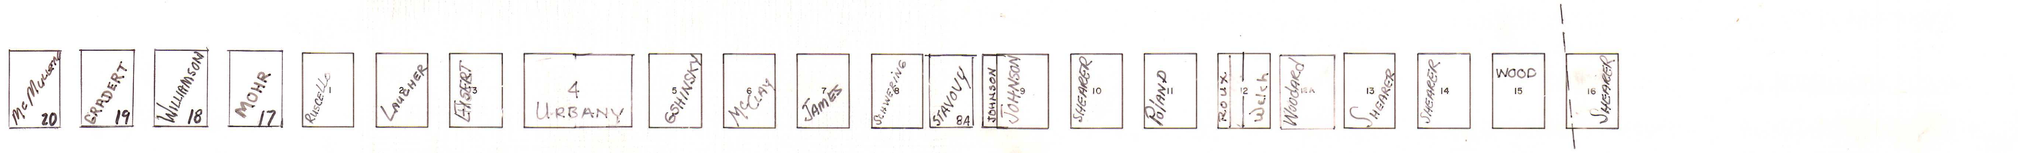

COLONIAL GARDENS / SECTION R

NICHES

SECTION G

ETHEL P. ZIMMERMAN 50	ALMA M. SMITH 49	MATHEW C. ZEDIKER 39	EMMA PORTER 32	PATRICIA D'ALESSANDRO 25	THOMAS J. HUGHES 28	CELIA DALTON 14	WM. L. M'DOWELL 7		
G. LESLIE ZIMMERMAN 51	45	SARAH J. ZEDIKER 37	WILLARD PORTER 33	ROSS P. D'ALESSANDRO 28	MARY KENSELMAN 26	MATTHIAS M. 15 DALTON	CHRISTINE K. 6 M'DOWELL	WILDA E. 2 DIXON	
52	46	CHILLUSS 40 ZEDIKER	34	B. D'ALESSANDRO 28	BRUNA 22 DOWLER	HETTIE W. 16 BEATTY	CRAMER T. 9 BEATTY	LEVI S. 3 ZANISER	
ANNE M. 38 PARKINSON	ROBERT W. 40 PARKINSON	LOUIS M. 42 ZEDIKER	NANNIE E. 35 LEE	JOSHA 28 LEONARD	JAMES H. 28 DUNN	CHARLES V. 17 MAISEL	WINIFRED E. 10 ZANNIZER	A. RUDOLPH 4 ZANNISER	
DAISY M. BARNES 54	REV. J. W. 48 BARNES	ANNE E. 42 ZEDIKER	SOPHIA 36 JAMES	DANIEL 30 JAMES	ELLA M. 24 VARNER	CALVERT G. 18 WILSON	DELLA C.B. 11 DAY	E. EDWARD 5 DAY	
55	ELEDA W. 49 BERT	HARRY W. 43 ZEDIKER	LAURA A 38 CAILE	ALLISON M. 34 MURPHY	JAMES R 25 VARNER	ELMER N. 19 REYNOLDS	SUSAN C. 12 BAILEY	GEORGE W. 6 BAILEY	

SECTION E

SAMUEL 49 MOSIER	THOMAS H 43 GWEEN	MABEL D. 39 GWEEN	[illegible] 31	MATTIE P. 25 HORN	JAMES S. 19 LEWIS	DR. JOHN B. 12 JOBES	NANCY 6 JOBES		
EDNA M. 44 PRATON	CHARLES F. 42 ROSS	ANODE V. 34 ROSS	THOMAS M. 30 SHRONTZ	AMIE E. 24 SHRONTZ	ELLA H. 15 LEWIS	JOHN R. 11 KAHL	JANET C. 5 KAHL		
ROBERT E. 47 MAXWELL	SAMUEL B. 41 DAGUE	MALINDA H. 35 DAGUE	WM. T. 28 COURSON	SIDNEY W. 23 COURSON	O.C. 17 DUNCAN	ROBERT E. 10 RIGGLE	ELIZABETH 4 RIGGLE		
SHAN M. 46 GRIFFIN	W. E. 46 DAGUE	ISABELLE K. 31 DAGUE	OWEN S. 28 BRADFORD	SARAH E. (LITTLE BIRDIE) 22 BRADFORD	MAUDE L. 16 DUNCAN	JAMISON F. 9 BALDWIN	SARAH J. 3 BALDWIN		
SARAH R. 45 GRIFFIN	ETHEL G. 39 DAGUE	ROSS A. 33 LEYDA	REV. ELMER M. 27 ELLIOTT	WALTER W. 21 ELLIOTT	15	JOHN W. 8 BAKER	MARY E. 2 BAKER		
JOHN H. 44 LAIRD	MARIE P. 36 LAIRD	WINIFRED V. 32 LEYDA	JAMES 26 DUNN	CLARA 20	WM. H. 14 NEAL	MARTHA 7 ESTERBROOK	THOMAS T. 1 ESTERBROOK		
ANNIE M. 44 IRWIN	ALVERTA G. 38 MOORE	WM H. 32 MOORE	SARAH W. 21 M'CAULEY	JOHN K. 20 M'CAULEY	SUSAN C. 14 SHORT	JOHN K. 7 LAWSON SR.	ETTA G. 1 REISHER		
ELIZA. J. 45 WEIR	ELVA. H. 37 M'CLURE	LULU D. 33 BUMPUS	WILLIE J. 28 PHILLIPS	WARREN J 21 PHILLIPS	ANNE B. 15 HAZLETT	LED B 8 ROBERTS	EDWARD G. 2 REISHER		
SAMUEL G. 46 WEIR	[illegible] 46 YOUNG	[illegible] 34 YOUNG	ZILLAH R 32 GARDNER	FRANK M. 22 GARDNER	WM 14 HAZLETT	CLARA J. 9 ROBERTS	WM L. 3 ROBERTS		
47	ANNA H. 41 CURRY	MILO W. 35 CURRY	WILLIE H. 26 WEIRICK	WM REED 23 WEIRICK	JOHN M. 17 TEMPLETON	EMMA 10 BEATTY	THOMAS 4 BEATTY		
JONNATHEN E. 45 PARKINSON	LOUIS W. 42 PARKINSON	[illegible] 36	MARGARET B. 24 SNEE	ARCHIBALD R. 24 SNEE	JEANNETTE M. 18 TEMPLETON	LENNIE C. 11 DEVORE	CHARLES 5 DEVORE		
49	REUNER 43 TEMP.	AMOINI 37 TEMP.	EMMA J. 21 PAUL	JOHN A. 25 PAUL	MARY J. & MINOR 17 TEMPLETON	CHARLOTTE D. 12 GANIER	GRACE A. 6 BEATTY		

SECTION C

SECTION A

WILLIAM 49 FLEMING	STEWART C. 43 ROBERTS	[illegible] 37	HAZLETT M. 31 BELL	MARY 25 BELL	JOHN J. 19 WALTERS	ANNIE E. 12 WALTERS	HAZEL L. 6 MILLER
MARGARET 48 FLEMING	AMY 42 ROBERTS	HAVEN C. 36 ROSS	DANIEL C. 30 DAY	LULU J. 24 DAY	LUNNIE B. 18 BOYD	JOANNE E. 11 BARRE	BERTHA M. 5 ZEDIKER
WILLIAM 47 FLEMING	BIRD 41 ROBERTS	FRANK L. 35 ROSS	BENJAMIN F. 29 M'CLANE	FLORA B. 23 M'CLANE	CLYDE S. 17 MOORE	IDA MAE 10 MOORE	JOHN H. 4 ZEDIKER
JEAN 46 FLEMING	CORA E. 40 ROBERTS	MARGARET W. 34 ROSS	28	FRANK P. 22 LEWIS	DRUSA. 16 MANON	MAUDE 9 MANON	ROBERT 3 BURNSIDE
ROBERT A. 45 WEIR	JOHN F. 39 FLEMING	33	DAISY F. 27 FONNER	MARTHA 21 LEWIS	J. WESLEY 15 ZIMMERMAN	INFANT 8 JIMPSON	ETHEL 2 BURNSIDE
INEZ P. 44 WEIR	Henderson TEMP. 38	Henderson TEMP. 32	GEORGE P. 26 FONNER	RAPHEL H. 20 SHORT	BERTHA ZIMMERMAN 14	FRANK 7 WALLACE	CLARA 1 WALLACE

1	MARY K. COEN
2	CHARLESS COEN
3	EVA MAE COEN
4	G.W.P. JONES
5	ELLA M. JONES
6	
6	C.W. DELIA F. WALLER
5	MARY L. CRISPIN
4	WM L. R. CRISPIN
3	MARTHA W. CRISPIN
2	DR. JOHN K. STRATTIFF
1	SARAH M. LAWTON

SECTION H

GLADYS M. HESS	AGNES M. 7 M'KEE	DAVID 14 M'KEE	ETHEL M. 20 DEFIBAUGH	A.G. 22 DEFIBAUGH	HARRIETT 32 HILL	HARRIETT 35 GANYAN	JESSE B. 44 GANYAN	ANNA M. 50 BERTHEL	
JOHN C. 9 HESS	EDITH K. 2 HESS	MARY A. 9 WELSH	MARY E. 11 WELSH	32	CHARLES L. 33 HILL	LEWIS H 27 EVANS	RALPH 28 HOOTMAN	E. WEA 34 REYNOLDS	ELIZABETH 46 STEVENSON	WM FRANCIS 46 STEVENSON	FRANK H 52 BERTHEL
JENNIE V. 4 KING	JOHN L. 10 KING	JOSEPH R. 17 LISTON	BERTHA D. 23 HOOTMAN	DR. MAX J. 29 HOOTMAN	JENNIE M. 35 REYNOLDS	SARAH C. 41 POWERS	ALICE M. 47 WEBSTER	HARDIE H. 53 JENKINS	
ADAM 5 WASSELL	ALICE C. 11 WASSELL	JOSEPH R. (SR) 15 LISTON	EDWARD E. 24 BURR	JOHN L. 30 BURR	CHRISTINA 36 REYNOLDS	ANNA M. 42 WEBSTER	CHARLES M. 48 WEBSTER	HARRY L. 54 WILLIAMS	
MILDRED S. 6 WATSON	MARGARET J. 12 WATSON	RALPH 19 WATSON	ELSIE L. 25 BURR	JOHN A. 31 BURR	BEN 37 REYNOLDS	DAVID 43 BORROWS	CLAUDIA C. 49 BORROWS	BLANCHE M. 55 WILLIAMS	

SECTION F


AUBREY E. 6 FLINN	NETTIE C. 12 BROWN	OTTO W. 18 AKINS	WILLIAM H 25 GRIFFITH	ANNA R 31 CAMERON	CARL G 37 MIRANDA	SILVERIO 43 VALENTI	[illegible] 49		
ARTISSIMA M. 5 FLINN	SAMUEL 11 FLINN	SARAH J. 18 AKINS	ELIZABETH J. 24 GRIFFITH	HENRY W. 30 HERN	JAMES A. 36 WISE	42	48		
JOHN GRIFFITH 4	MARY E. 10 GRIFFITH	DR. WILMONT 17 CROMRINE	JESSIE G 23 LAYTON	MARY C. 29 HERN	WALTER G. 35 DOAK	MARIES SABINA V. 41 CAVANAUGH	47		
D. E. 3 THOMAS	JENNIE L. 9 THOMAS	JUANITA A. 16 CROMRINE	GEORGE 22 LOAR	MARY M. 28 BRIGGS	ADA, M. 34 DOAK	AMERICA A. 40 SIMPSON	VICTOR W. 46 ENGLE		
PARTHENIA E. 2 PATTERSON	JOHN M. 8 ANDREW	MARY E. 15 BYERS	J. 21	JOHN T 27 CLUTTER	JOHN P. 33 HOFFMAN	DUDLEY B 39 HUGHES	RUTH S. 45 BAILE		
DAVID C. POST 1	MARY P. 7 POST	JACOB M. 14 POST	J. LEWIS 20 HOGE	MINERVA 26 CLUTTER	NANCY A. 32 HOFFMAN	SARAH E. 38 HUGHES	SAMUEL 44 BAILE		
AUGUST SHOES 1	LEROY M. 7 SPEICHER	14	MARY DOTY 20 MINTON	GEORGE W. 26 MINTON	ELIZABETH E. 32 SCOTT	J. OLIVER 38 SCOTT	SARAH MARIANNA 44 SPROWLS		
MINNIE M'MURRAY 7	WILSON M'MURRAY 8	CLOE DOWIE 15 GOFF	HATTIE M. 21 M'MURRY	JOHN R. 23 M'MURRY	ETTA B. 33 BERT	MARY HENRY ELLA MAUD 37 HUGHES	45		
JAMES 3 CONNER	LUCY 9 CONNER	16	ELLA FLINN KELSEY 22	WALTER M. 28 KELLEY	MARY L. 34 KEPPLE	FLORA 40 PHILLIPS	ALICE DOAK 46 DOAK		
ELIZABETH M. 2 POWER	JOSEPH WILSON 10 POWER	CLARA M. 17 COOK	MABEL HEREN 23 MARTIN	REV. WILLIAM S. 29 MARTIN	GEORGE M. 35 WOLF	GEORGE E. 41 LIANI	JESSAMINE 42 JONES		
JAMES E 5 BLACK	ELIZABETH ROMAINE 11 BURROS	ROWLEY M. 18 COOK	NETTYE G. 24 MOUNTS	E. E. 30 MOUNTS	RACHEL GLOSSER 36 DOAK	SAMANTHA J. 42 LIANI	HANNAH 48 WILSON		
CLARISSA M. S. 6 EASON	ALBERT E. 12 SOUTH M.D.	VIOLA 19 BLACK	CLARA E. 25 BIGLER	WALTER S. 31 BIGLER	ELLIS CARSON DOAK 37	MARY G. 43 COX	CLARK 49 WILSON		

SECTION D

SECTION B

1 RICHARD M. BRADY	HARRIET BRUE 6 DAUGHERTY	BERT 12 JONES	ALEXANDER T. 19 ANDERSON	DANIEL HALL 25 GOODWIN	ANNA REYNOLDS 31 GOODWIN	SOLOMON 37 WINSETTER	D. M. L. 43 WINSETTER	SARAH HAMILTON 49 WINSETTER
2 FLORA B. DONNAN	STEPHEN B. 5 DAY	REBECCA J.C. 11 DAY	KATHARINE WILSON 18 HENDERSON	J. ROSS & INFANT 24 SMALL	ELVA VINNIE 30 SMALL	JOSEPH H 36 NESTOR	BLANCHE M. 42 NESTOR	AUGUST 48 DIETZ
3 SYDNEY B. DONNAN	FRANK H 4 THOMAS	CHARLES H 10 BUMPUS	WILLIAM A. 17 POTTS JR.	W. D. 23 ROBERTS	MINNIE J. 29 ROBERTS	ROBERT J. 35 STEWART	HARRIET & 41 DAVIS	LOUISE RUBELLE 47 DIETZ
4 MARY L. BRADY	ELIZABETH CAMBLE THOMAS 3	ANDREW 9 COOGLE	JAMES H 16 MANON	SAMUEL M. 22 MORLAN	ELIZABETH A 28 PIERSON	JOHN M. 34 SEESE.	ETTA C. 40 SEESE	JANET 46 THIELEMAN	
5 MARY P. BRADY	GEORGE W. 2 CUTTER	EMMA E. CLUTTER 8 CLUTTER	MARY RITCHIE MANON 15	CHARLES W. 21 ARCHER	JOSEPHINE 27 ARCHER	EVA M. 33 COWLEY	I VA M. 39 COWLEY	PAULA THIELEMAN 45 PATTERSON	
6 CHARLES N. BRADY	FRIEDRICH HERRMANN 1	FRANCESKA 13 HERRMANN	BESS MANON BALDWIN 14	SI. COOK SMITH 20	MARGARET 26 CHRISTIE	MAHALON L. 32 COWLEY	ELLA TOWNS 38 COWLEY	LLOYD S. 44 PATTERSON	
6 RICHARD M. FRAXTON									
5 MARY W. FRAXTON									
4 PEARL B. CARR									
3 ROY V. CARR									
2									
1									

COMMUNITY MAUSOLEUM

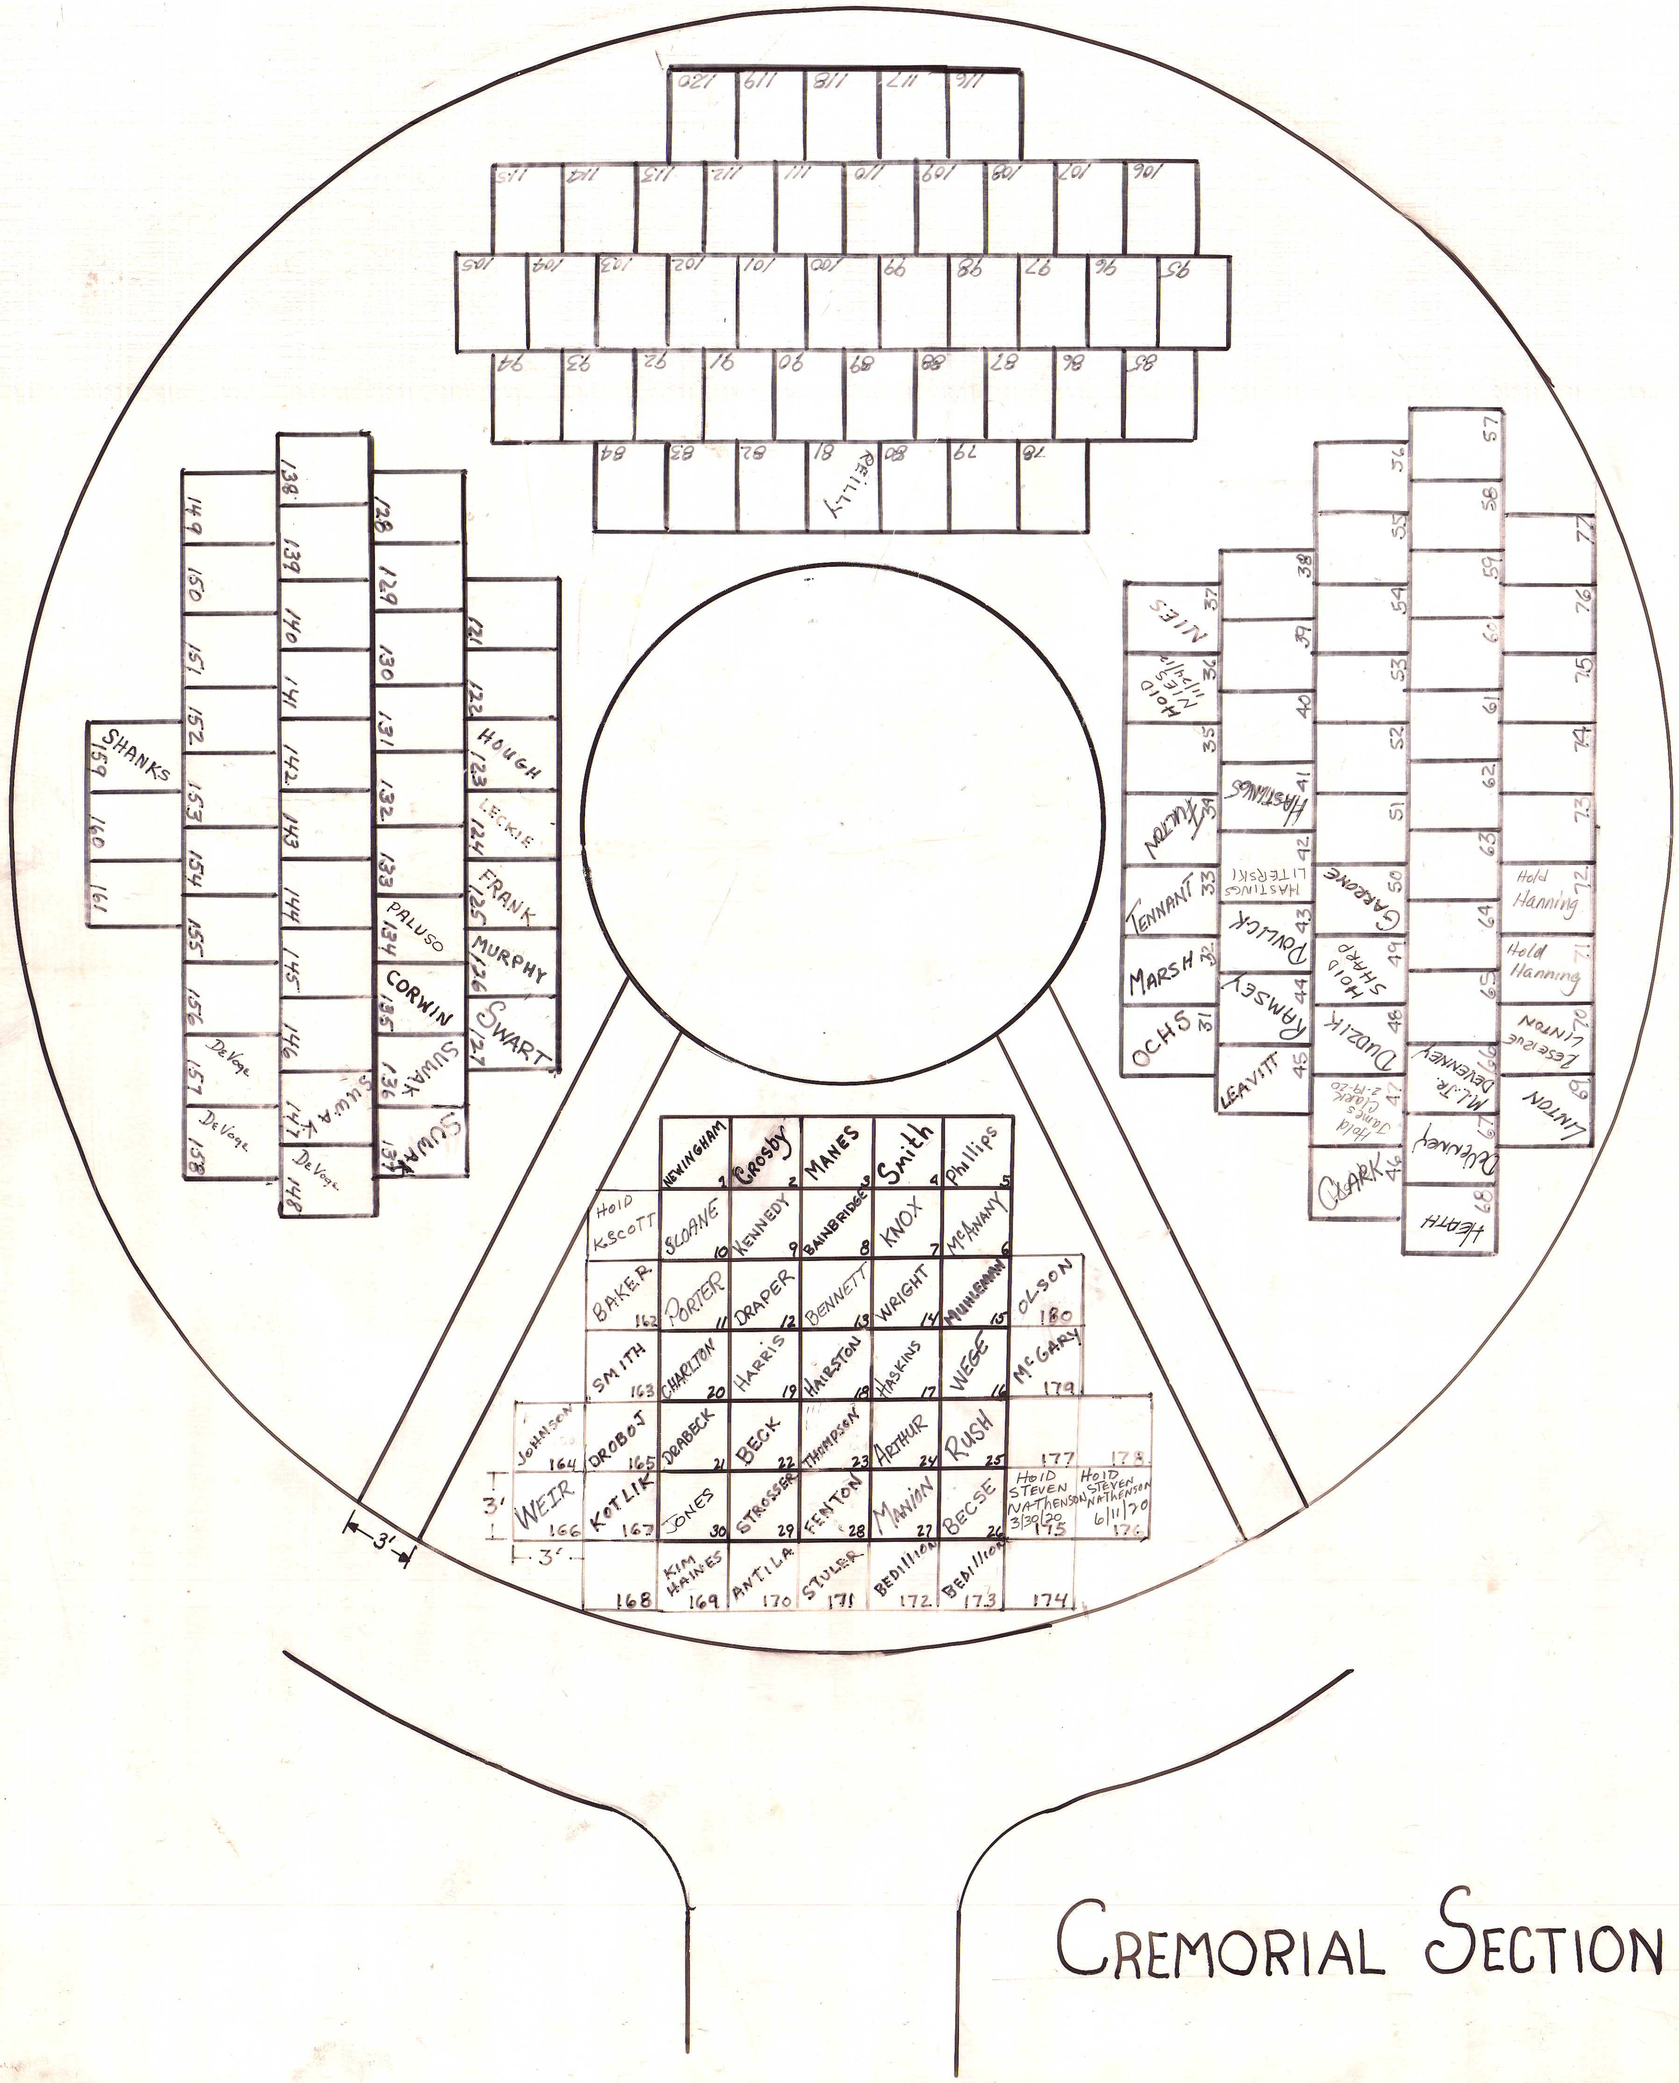

CREMORIAL SECTION

A	Burden Only - Will not Accommodate Cremains.		James G. Scalise	Gladys M Scalise		Josephine B. Michaels 1969	MARIE B. MILLER 1980					Border Only - Will not Accommodate Cremains
B			Robert A. Hopkins 1981	NORMA B. HOPKINS								
C												
	1	2	3	4	5	6	7	8	9	10	11	12

MAUSOLEUM CREMAIN NICHES


SECTION

McKENNAN CIRCLE.

WASHINGTON CEMETERY.

Scale 20 feet to the inch.
Lot number in red.
Dimensions in green.
Area in blue.
1904.

Lot No.	Name of Lot owner.
1	Elizabeth McWarne.
2	Elizabeth McWarne.
3	John A. Young = Samil McRedd
4	Mrs Catherine Miles.
5	Joseph Howarth.
6	Ed. R. Smith. Jr.
7	James A. Jordan.
8	Norton = James D. McGiffin.
9	Norton = James D. McGiffin.
10	Miss Anne V. Hagerty.
11	J. McMontgomery = James Milliken.
12	A. H. Little.
13	John McHazlett.
14	Dr Joseph Christie.
15	William Ely = Walter J. Ely W½ F½
16	Mrs R. W. Brownlee = H. McElree. N½ S½
17	James A. Little.
18	Daniel H. Clemens
19	William H. Parr.
20	Mrs Etta J. Kirk = J. A. DeNormandie Kl½ S½
21	J. Harper Wallace.
22	J. Wilbert Wallace.
23	William Wachter. B = Bird & Anchor S½ A
24	James L. Henderson.
25	J. D. W. W. = C. A. = E. A. = A. J. Sturgis.
26	J. D. W. W. = C. A. = E. A. = A. J. Sturgis.
27	Louis Snyder.
28	Louis Snyder.
29	Jonathan Allison.
30	Jonathan Allison.
31	Pierce C. Guerin. W½ = W. A. Meyers E½
32	C. A. Nichol.
33	Samil O. = Alice J. Houston.
34	Isaac A. Houston.
35	William C. Marshall.
36	Joseph L. Bradshaw.
37	Elisha = J. C. = H. R. Ely.
38	Hugh A. Rogers.
39	Thomas Hart.
40	Joseph L. Clemens.
41	Samuel Workman.
42	John C. Wilson.
43	Thomas Parr = Annie Reed = E. Brown
44	Emanuel Shearer.
45	John F. = Grant E. Heer. N½ S½
46	Jos. C. Barre.
47	George McBarre. = Joseph Prigg
48	L. McCarrell. Est.,
49	Alex Brown.
50	Albert McVester. = James A. Wiley
51	B. E. = S. Day.
52	James E. Wilson = Mrs Jane N. McBarre.

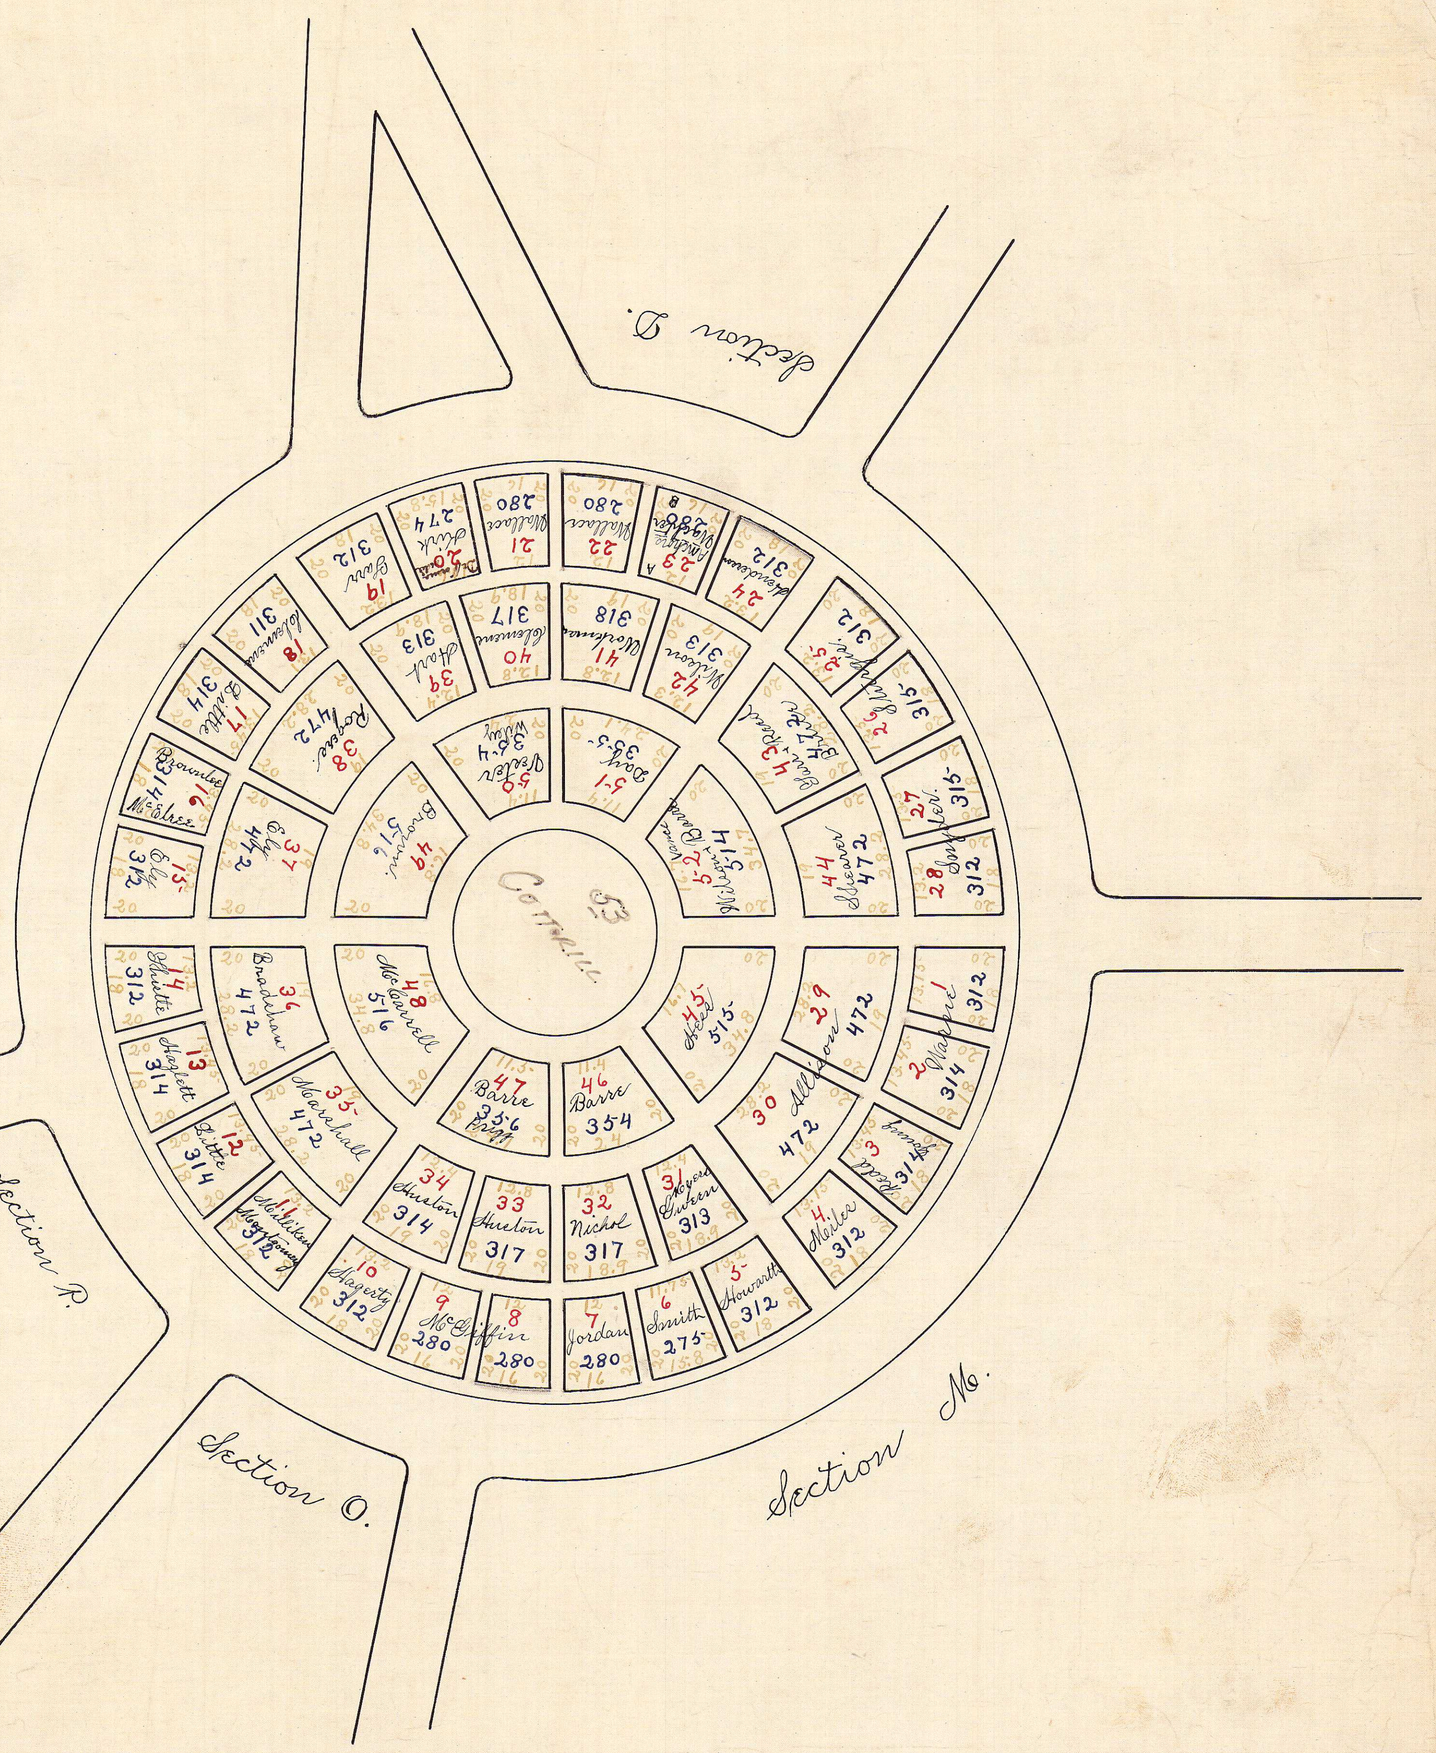


McKENNAN CIRCLE

SECTION.

Morgan Circle.

Washington Cemetery.

Scale 20 feet to the inch.
Lot number in red.
Dimensions in green.
Area in blue.
1930.

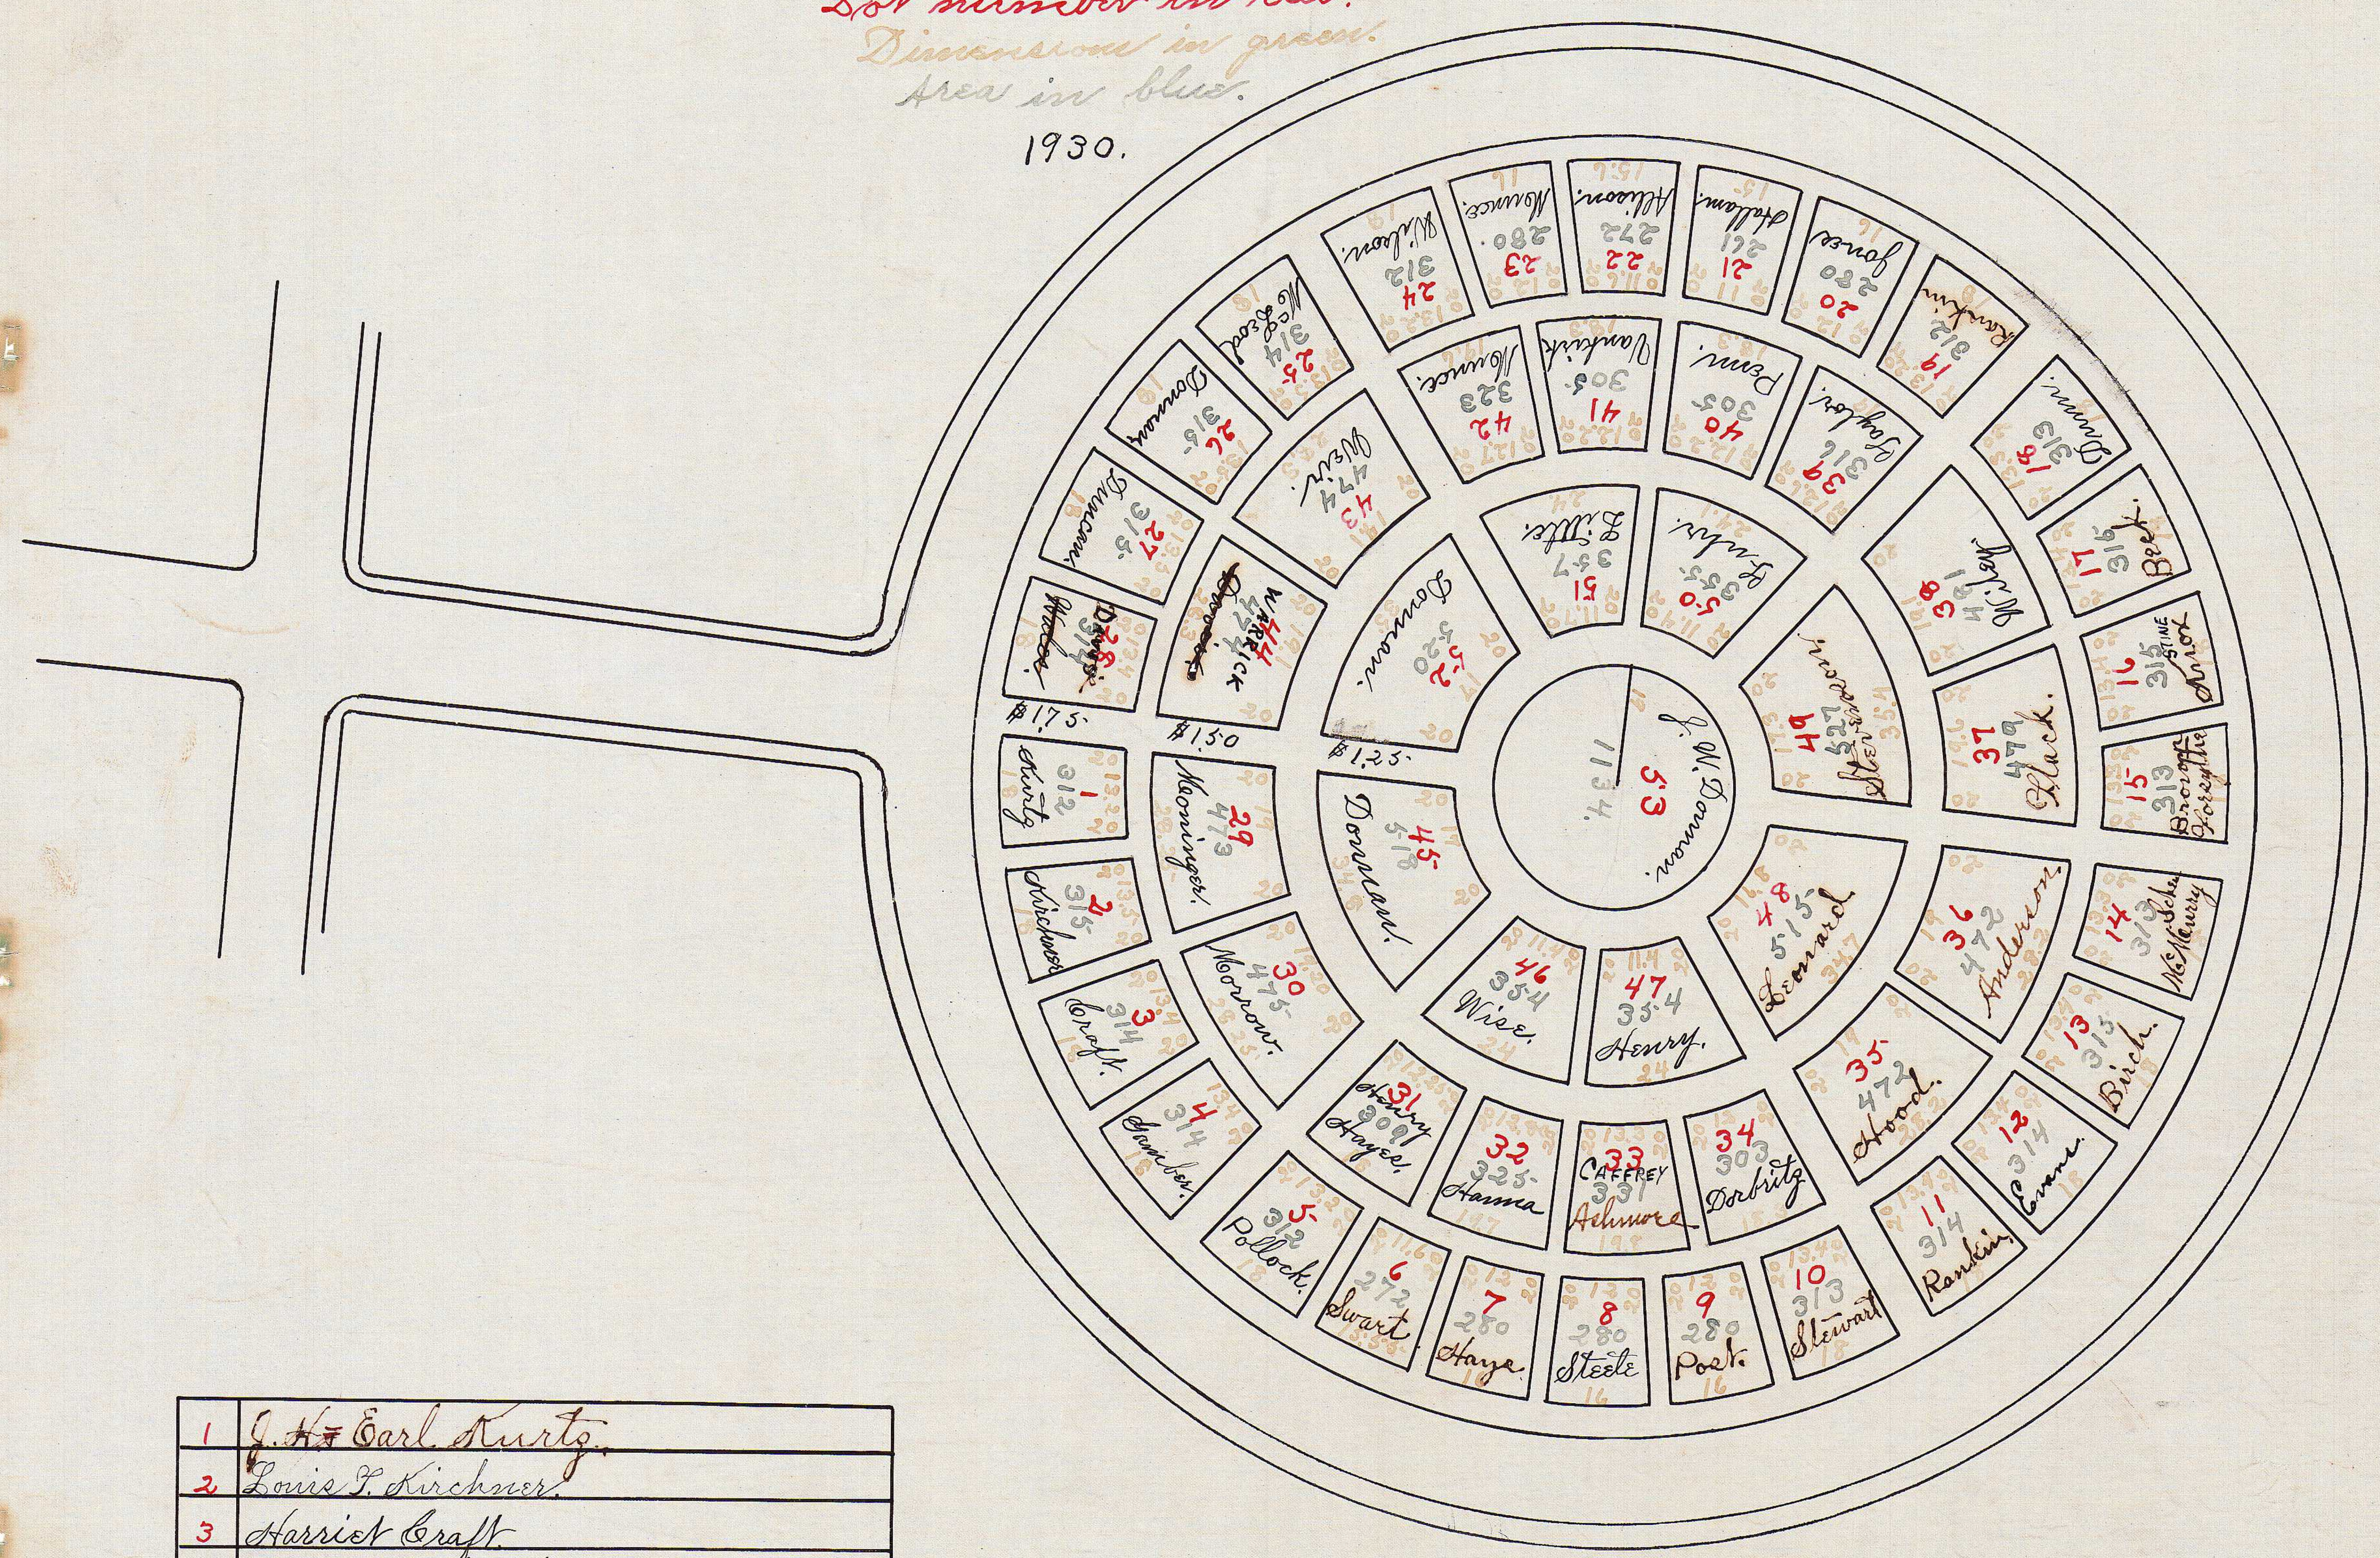

1	~~J. H. & Earl Kurtz.~~		
2	Louis F. Kirchner.		
3	Harriet Craft.		
4	Ray Belle Gamber.		
5	Harry E. Drell S. Pollock.		
6	David H. Swart		
7	Jennie E. Hays.		
8	Harry J. Steel.	31	Viola Mc Hays & Minnie Henry.
9	Mrs John F. Post.	32	Daisy A. Hanna.
10	Margaret J. S.	33	~~William Weir.~~ Lenore Ashmore
11	Mr & Mrs James H. Rankin.	34	E. O. Dorbritz.
12	G. Wesley Evans.	35	Annie L. Hood.
13	John W. Birch.	36	J. Howard & Walter Anderson.
14	~~John W. & George Mc. Vankirk.~~	37	John A. Flack.
15	William H. Brown. Wm H. Forsythe.	38	Mary Ann Wiley
16	J. R. Brown Knox W½ Sarah Knox. Vera Sten.	39	Jennie B. Taylor.
17	Dortha Beck.	40	Josephine Penn.
18	James H. & John C. & C. A. & Herbert Dunn.	41	~~John W.~~ & George Mc. Vankirk.
19	Elizabeth Rankin.	42	Robert J. Munce.
20	Albert S. Jones.	43	William Weir.
21	Russell Hallam.	44	~~William Davis.~~ George H. Warrick
22	Miss Blanche Allison.	45	J. W. Donnan.
23	William J. Munce.	46	J. Blaine Wise.
24	John N. & Bernard Wilson.	47	W. Blaine & Mary E. Henry.
25	George McLeod.	48	J. W. Sr. & J. W. Jr. J. D. & F. D. Leonard.
26	John H. Donnan.	49	Linda L. & Margaret N. Stevenson.
27	Thomas J. Duncan.	50	Sarah E. Fuhr.
28	~~Nellie F. Wales.~~	51	William A. Little.
29	Grant Moning	52	J. W. Donnan.
30	Cyrus Morrow.	53	J. W. Donnan.

MORGAN CIRCLE




Section 4 – Lot #357


Overall lot dimensions – top 28' left to right & bottom 32' left to right.

Graves #1 - #8 have been laid out to the far right side of the lot.

These 8 graves identified as lot #357 are defined by four corner markers installed at 16' top left to right and 16' bottom left to right.


The balance of the lot to the left identified as lot #357A measures 12' top left to right and 16' bottom left to right.

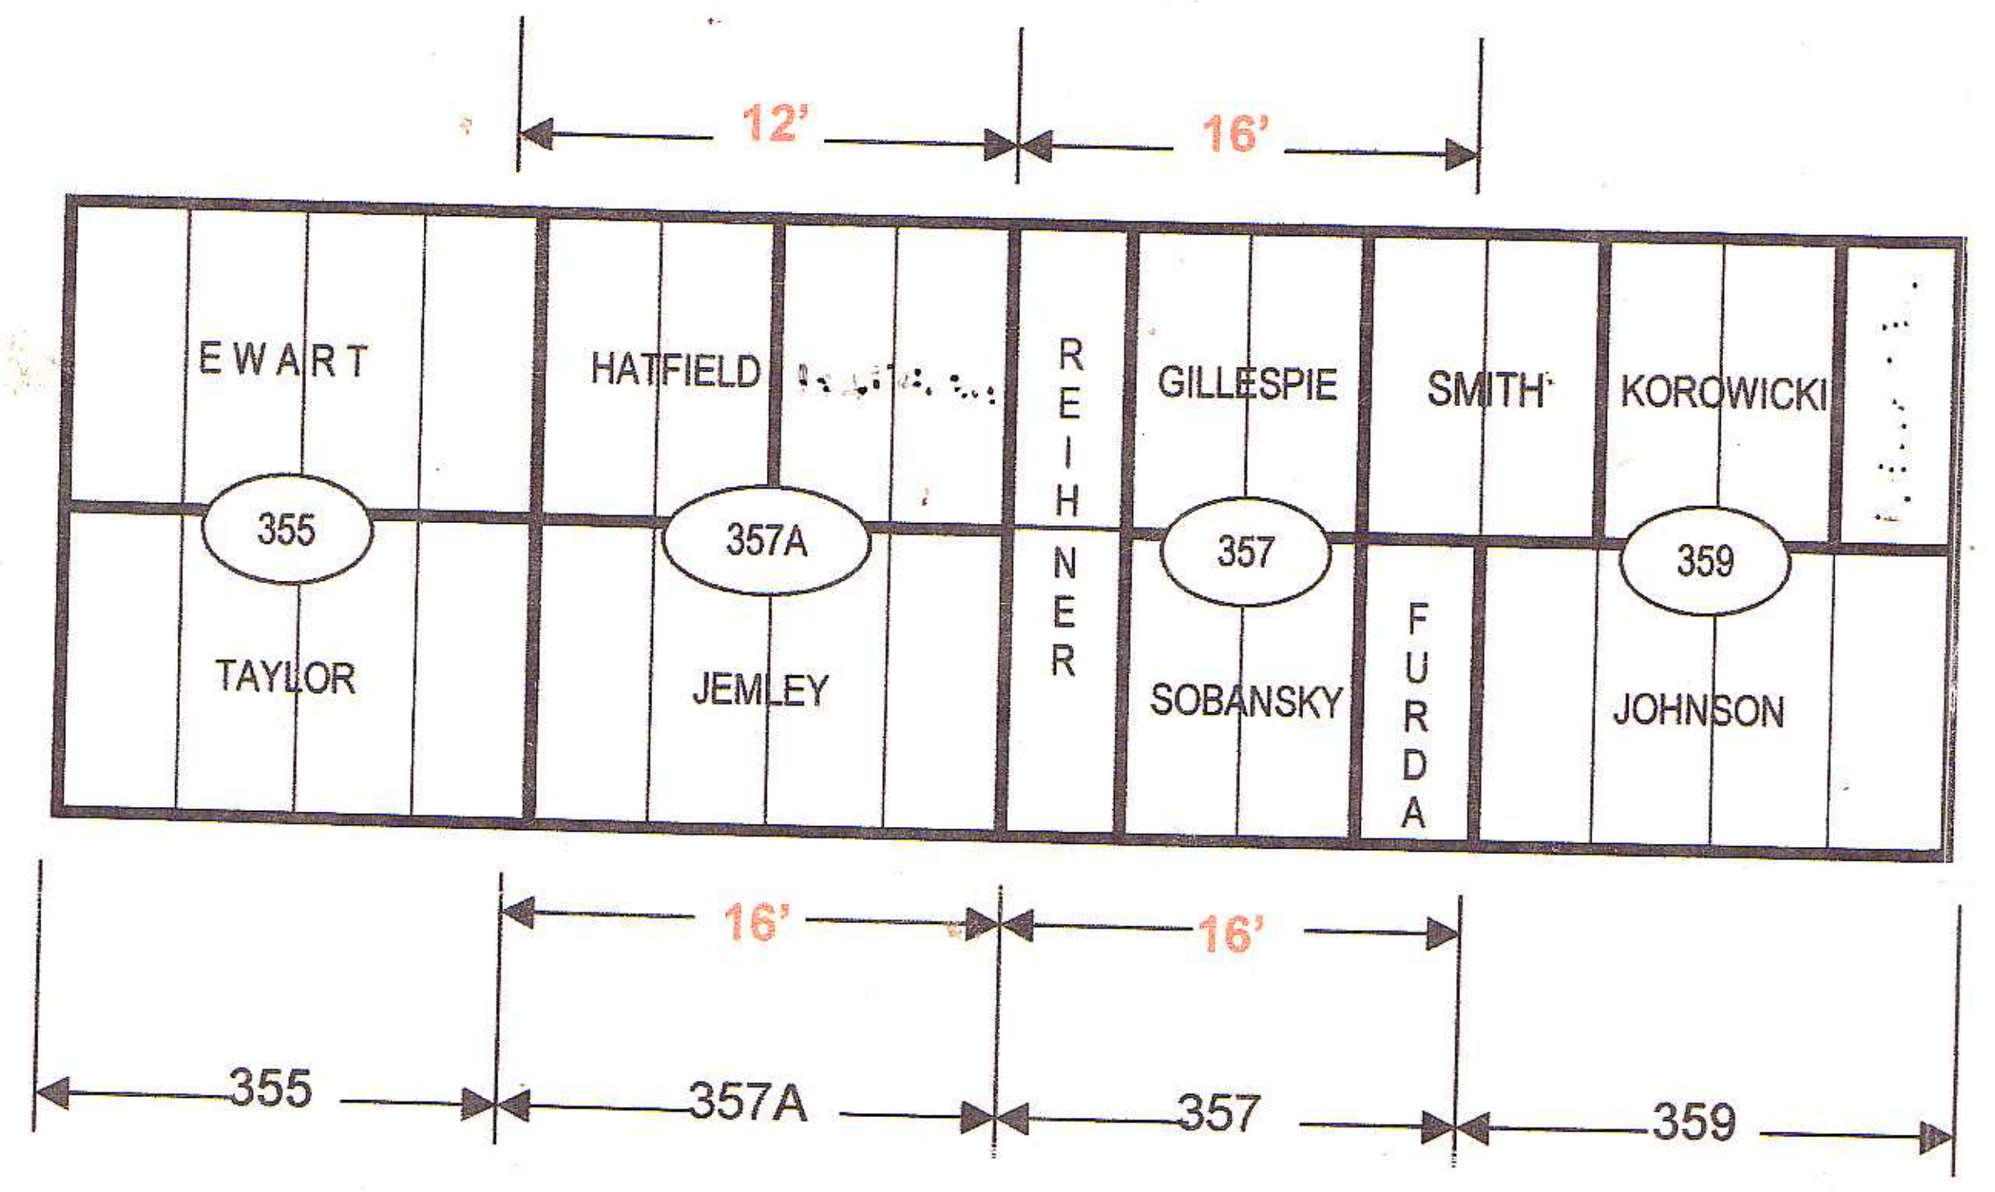

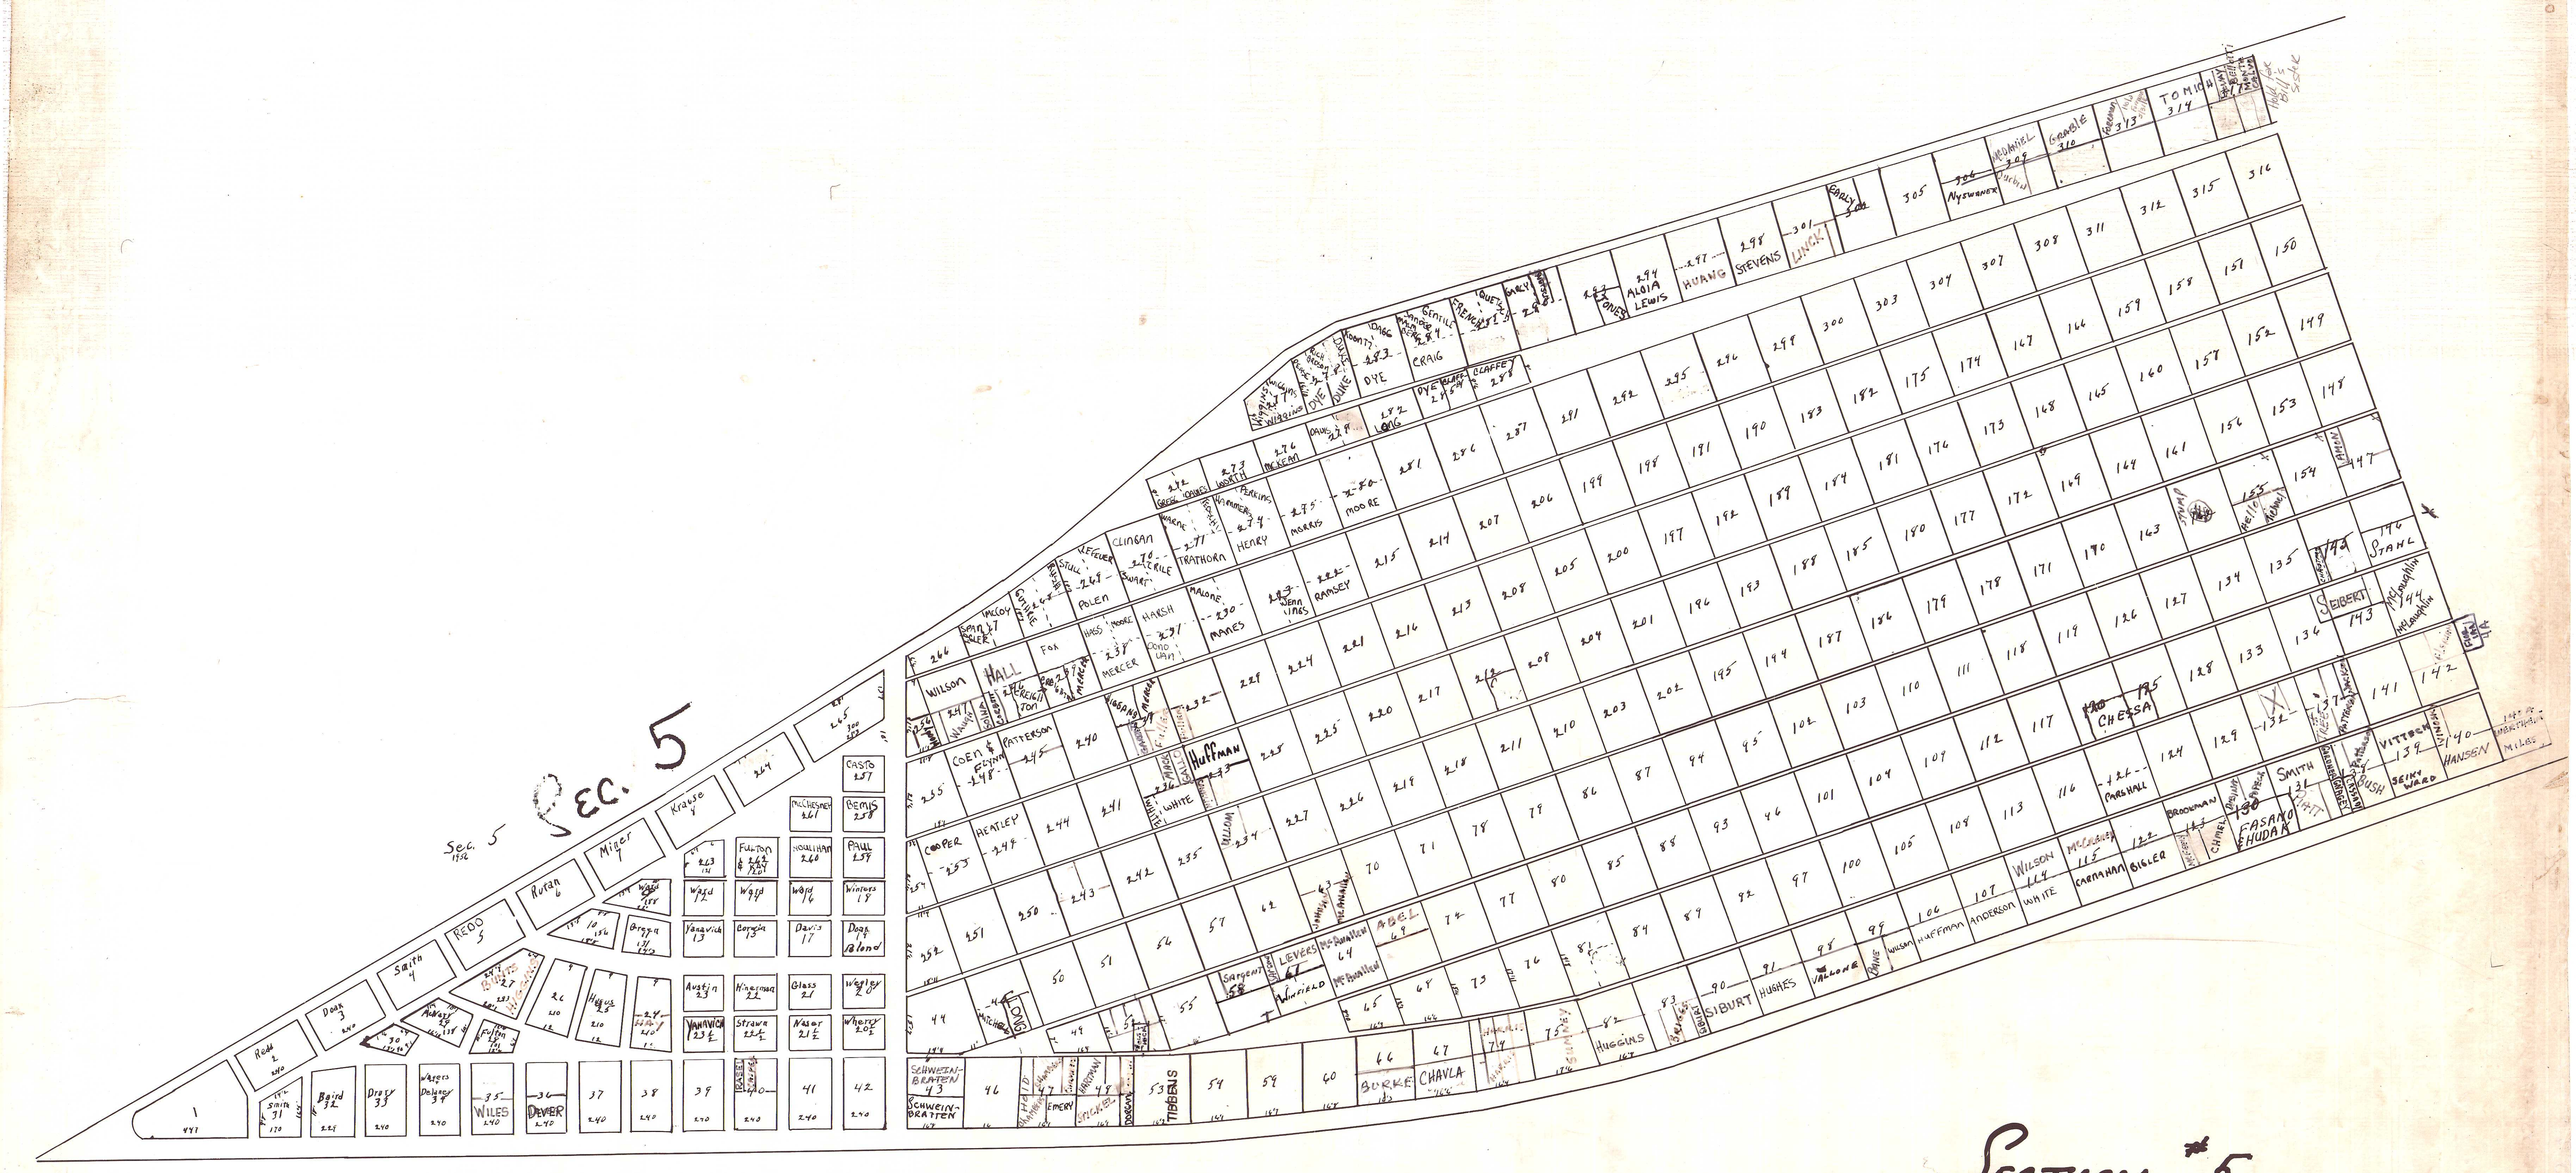
SEC. 5
Sec. 5 1932
Reed 1
Dean 3
Smith 4
Reed 5
Ryan 6
Miller
Krause
24
Winters 18
Wagley 20
Wherry 20½
Wiles 35
Dever 36
37
38
39
40
41
42
1
Baird 32
Drake 33
Wages 34
Fulton 243
Wood 12
Wood 14
Wood 16
Vanzwich 13
Georgia 15
Davis 17
Dean 19
Austin 23
Hinesman 22
Glass 21
Vanwick 23½
Strawn 22½
Nasar 21½
Boggess
Schweinbraten 43
46
47
48
49
53
54
59
60
Emery
Jennings
Thibeaus
Burke 66
Chavla 67
Huggins 82
Siburt 90
Hughes 91
Anderson 107
Wilson 114
McCauley 115
Cabaniss 122
Bigler
Fasano 130
Hudak
Vittetoe 139
Hansen 140
Smith 31
Seiler Ward
Cheesa 125
Parshall
Eiberg 143
McLaughlin 144
McLaughlin
Stanl 146
Mann 147
SECTION 5

THE WASHINGTON CEMETERY
SECTION #6

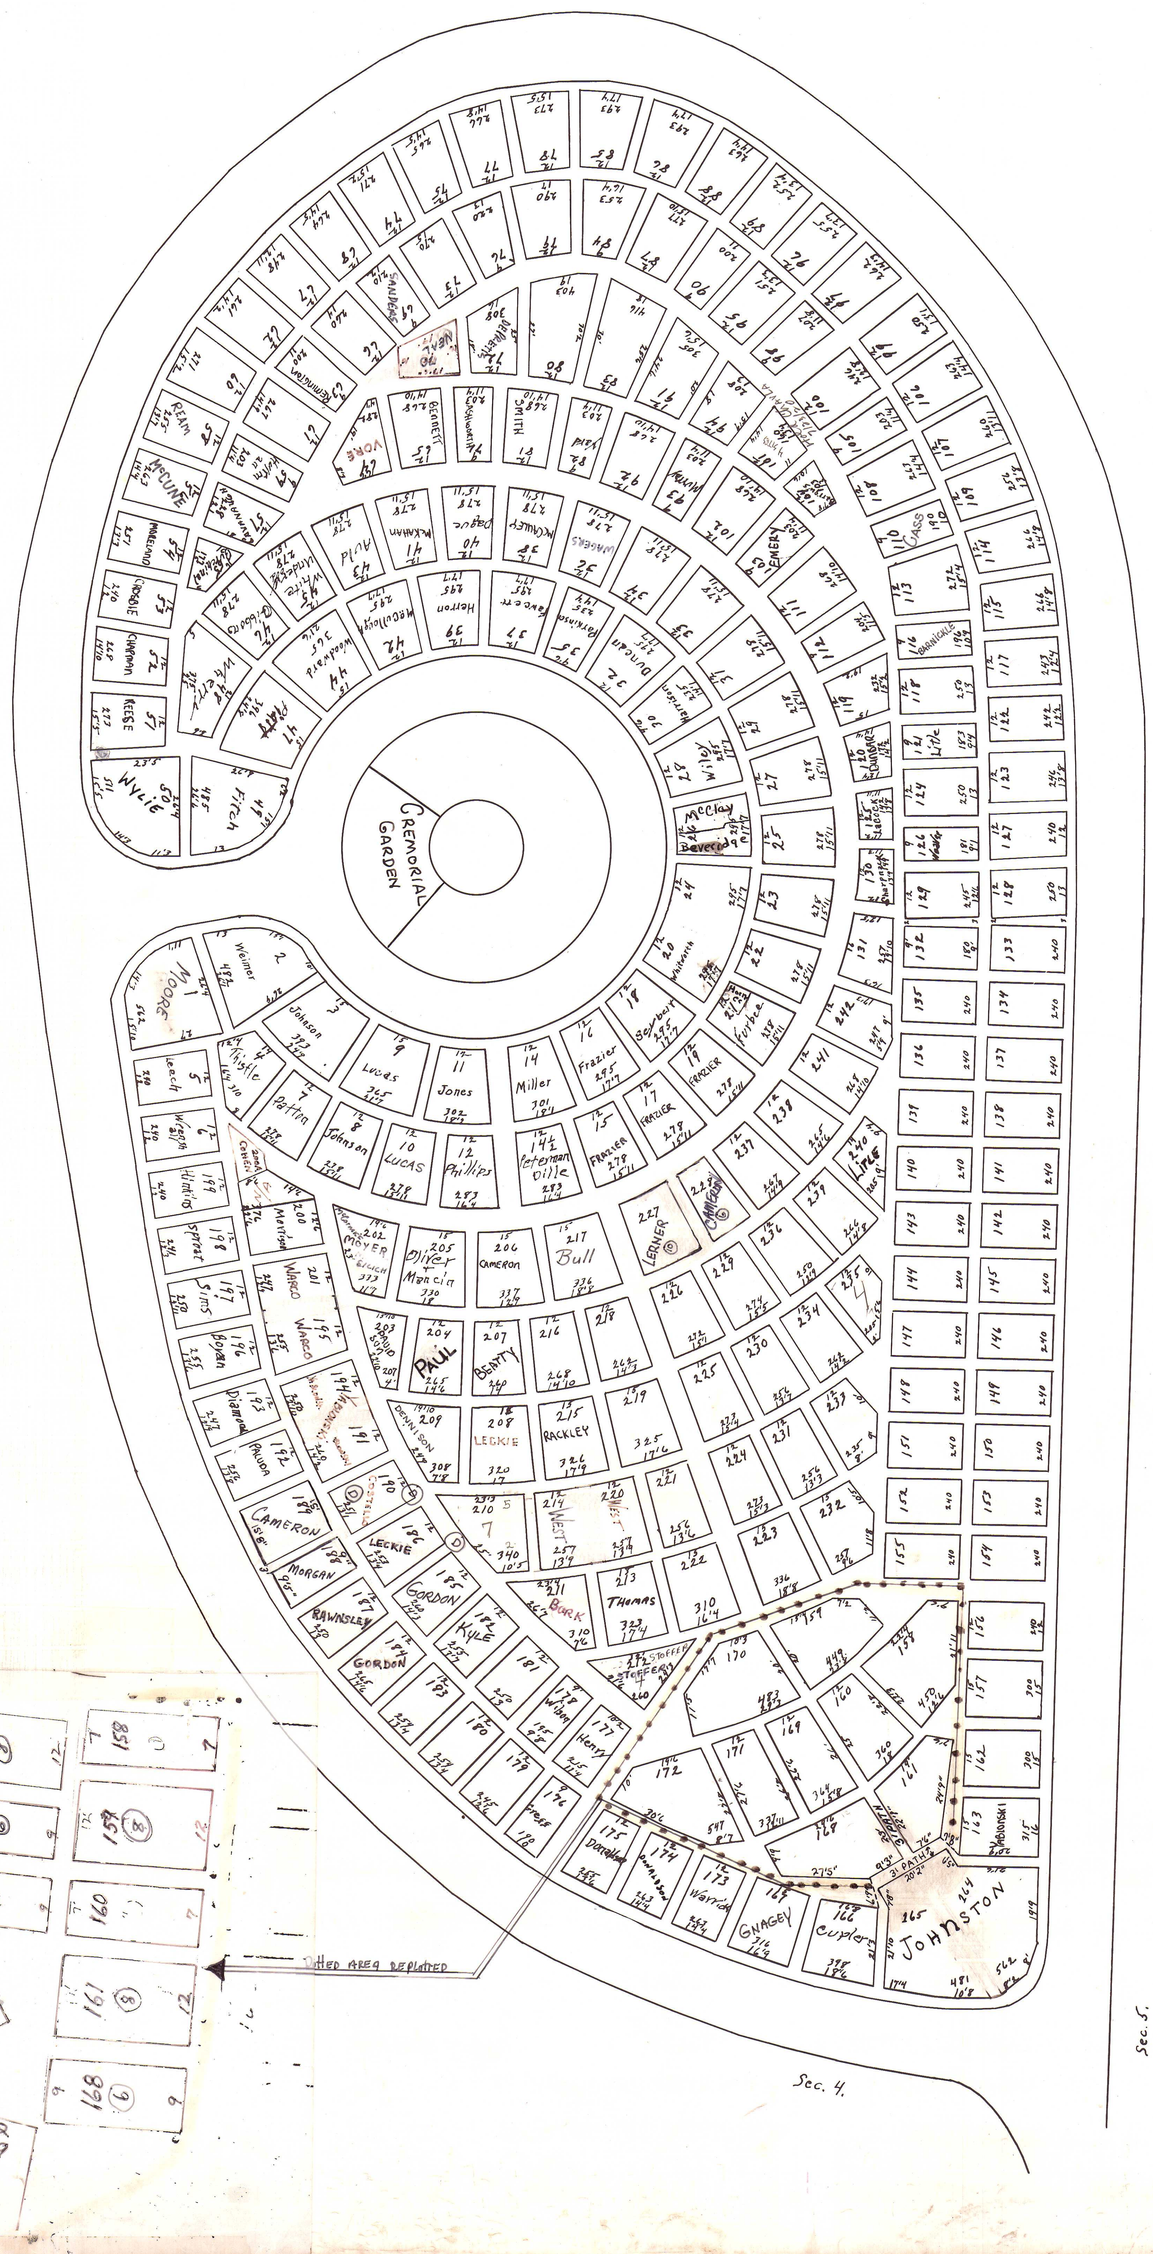
7'6"	7'6"	7'6"	7'6"	
HEBRANK 67	BECK 66	HEBRANK 65	DEVENNEY 64	91'
7'	7'	7'	7'	

59	58	57	56	55	54	53	52	51
McDOWELL	MORRIS	BIRD	WILLIAMSON	CRAWFORD	CRAWFORD	HAMMETT	REED	HOBBS

		LANGLOIS / JONES 45	CARLISLE 44	KARPAN / MOUNTS 37	KARPAN 36	YANKOVITCH 29	WILSON 28	SANTELLI 21	CRAMER 20	COKEL	BOWERS	BOWERS / LOBOZZO 12	BOWERS 4
		PETERSON 46	WALZ 43	PETTIT 38	MICKANIN 35	YANKOVITCH 30	LINDSAY / FUNK 27	CLEMENS 22	BOWERS 19	WILSON & FERLING 14	BOWERS 11	LOBOZZO 9	MORRIS 3
TOWNSEND 49	RUSSELL / CONNOR 50	COLLIER 47	PLANTS 42	GRABOWSKI 39	SELVAGGI 34	YANKOVITCH 13	SHELLOGG 26	CHIPPS / HATHAWAY 23	PICCIONI 18	BIGLER 15	BOWERS 10	LOBOZZO 7	CRUPE / COMBS 2
HENSEL 48	HOWARD 49	COLLIER 41	MUNDELL 41	DYSON 40	AHRENS 33	YANKOVITCH 32	BECK 25	MARSHMAN 24	COMER 17	BOWERS 16	WARNICK 9	LEE 8	CRUPE 1
YODERS 63													

SECTION 8





SECTION #9


ADAMS 5 6
MILES 3 4
No 1 & 2 AND 7 & 8 (4 ONLY)
Note: Lot # 17 : Adams 5 & 6 should have been numbered 1 & 2. but wasn't.
Adams returned 5 & 6 to cemetery. Corrected numbering to 1 & 2.
INGRAM CALLAGHAN Thomas 228 SORGE McCLAIN BEDILLION HUGUS 227 Kosneck GANAWAY MYERS Ingram CHASE COHEN 226 HATHAWAY WEANER SILVERMAN 63 BREHL SILVERMAN CLAFFEY HULL 62 FRAZIER RAMEY DENTAL McCLANE MAYNE 61 OLIVERIO ADAMS MYERS SMITH 60 McKAY RUSH LEE COBB 58 McVEHIL BROWNLEE KOPKO 56 POWELL HIGGINBOTHAM CARPENTER DURBIN 54 JEFFERS HAMILTON HORNE 52 CARPENTER SICKLES ADAMS HARRIS DUNCAN 50 SICKLES SICKLES ENGLISH 48 SICKLES HUMBERT TYLER WHITE 47 Phillips Hunnel BUCKLEY BONNER BONNER ISAMIGER 43 ISIMINGER LACOCK WAYNE DICKINSON 42 TREE HUNNELL HUNNELL TREE KELLEY MANSFIELD 37 MOORE WERNER BOSWELL FREDERICKSON 36 FENWICK PETRI WILSON 31 WILSON PRESTO COLE 30 WILSON MILLER MINNIES MILLER 24 RUNDQUIST RIGGLE REED 23 LENHART EIBEN GILES MARTIN 16 KRATT CRAWFORD KRATT 15 DERROW GALLAGHER ECKERT McCURDY 8 CRILE BEBOUT YOUNG NETTLE PATTERSON KEENER
229 TARR 230 MUSTO BARNEY 225 FRIEND ALLEN EIMER 65 DIXON KITTLE STONER 68 MAST 64 CHARLTON BEATTY 69 CARPENTER DOYLE KENNEDY 70 THOMAS STEN PETROCELLE 77 CHANEY HARTER DICKINSON WYETH 78 WHITE CARPENTER BROWNLEE HAYES 57 CLEMENS CLEMENS 55 WHIPPLE CLEMENS WALKER 53 EHNERT WHITEMAN BLANKINSOP JULES JULES 51 GUIDAS BURNFIELD GUIDAS MEFFORD 49 KLUTCH BARD CHRICKLEY 46 PETERSON PATTISON WHEATLEY 44 NICHOLS MILLER KINNAN 41 ARNOLD 38 FLAHERTY 35 FOX NEVIN MANES 32 STEINER COWDEN GESHAY 29 RIGGLE PETERS TREE GUMP 26 BAKER LONG RIZAK 25 WILSON MILLER 22 REED 17 MILES DUBICH GAITHER 14 no sale
MARINSKI SMITH HULL HULL GANAWAY 231 WYETH 224 MARBLE ANDERSON JOHNSON 66 GRIMES ELDER ORUM FULLER 67 DUNKLE LIGHTNER PIERCE FERLING SPROWLS WELCH ANDERSON McVUGH McWHORTER 71 BURKE DUNN WONSETLER LUELLEN ROBERTS 76 MITCHELL SHRADER HASKEY CUMMINS MARBLE 79 THOMAS KUSKY FIELDS KUSKY 84 PELIPETZ FAVORITE NICHOLS 85 BRESORK NICHOLS LUCASKY 86 WEDDLE SCHAFER SCHAEF McCONNELL 93 KINNAN KINNAN KLUTCH 94 PYLE DAVIDSON STEFFICK 101 BLANKINSOP KING BAKER BRENNAN CRICKLEY 45 FISHER WHEATLEY PHILLIPS SOBILO TREE 40 TREE SHODIL SHADEL REED REED DAVIS 39 DAVIS HAMPE DAVIS 34 QUAYLE KNESTRICK HAINES SPROWLS 33 CAFFREY CAFFREY 28 LOVELLE GRAY SOLINGEN 27 BAKER WEANER RICHARDS FULLERTON 21 KELLEY CHAMBERS BAKER MILLER 18 BELL POLACEK MILLER 13 KING MAURER CRAWFORD 9 STARRICK BLAZIC FITZGERALD FINDLEY 7 THOMPSON BALDWIN GURA 2 GARDNER BALDWIN
232 ANDERSON STAHLBERG 223 McCartney LIVINGSTON BATSON 222 McConnell JANKOWSKI SNYDER 73 DORSEY CLARK 72 FULLER LIGHTNER SIMPSON KNESTRICK MORRIS 75 MAINE BEDILLION BARBOUR 80 DOWDLE HUNT HUNT TANNER 83 KING BROWNLEE McCARTNEY OPENBRIER 87 CALL LINDLEY BURT 92 WILLIAMS SCHWERING POLEN BAXTER PHILLIPS 95 ZIMMERS DOMAN McCRACKEN 100 BENNINGTON WOHLGEMUTH COUTS COUTS 103 ROHRBAUGH DAVIDSON BERRY 102 LANG BURT BRIGGS COWAN 109 SABELLA VOORHES HATFIELD ROSS 110 BARNHILL ROACH ORMISTON 117 HOUSTON NELAN HOKE BEIGHLE 118 WARNICK FILOSI RICHARDS THOMPSON 20 GAMBLE PRALL DIEBOLD SEAL 19 SEAL FIELDS 12 FIELDS RANDALL 10 HUTTER BOARDLEY BRADLEY BLAZIC BIRD DOLAN 6 O'BRIEN BEDILLION KING 3 MARTIN LEE no sale
PIERSON PIERSON 233 PIERSON PIERSON 221 McCLOSKEY ALLEN TEBALT 220 PORTER JONES McDOWELL 74 ALLEN MANSFIELD McCOLLA 81 RIDING KISNER HUTTER LEINEWEBER 82 ARENT EUSTIS POLAN 88 HAMIL PATTERSON SCHMIDT OPENBRIER PARKINSON 91 FISHER CONNORS GARRETT 96 COLLINS SMITH GRAY LANG 99 HENNEN DURBIN HOOVER RIGGLE & DACTON 104 PETITE VANCE GOSLIN HARTER BEDILLION YEAGER 108 YEAGER THOMPSON HANEY 111 STAGE BATSON NYSWANER 116 CLUTTER HOUSTON & ROCHE PERRY BEIGHLE 119 OPENBRIER HOUGHTON TARR 125 BENNETT GHIST 126 BENNETT DOPLER BECK STEEL GRAY 133 WHITEMAN BELL POWELL NEWHERNE ZEMMER OSBORN 134 CLARK VESTER ROSS LIPINSKI LYDICK 11 LYDICK WILLIAMSON WILLIAMS 5 WILLIAMSON DRIEHORST WILLIAMSON RUSH 4 SMITH BIRCH
DERROW 234 SCHUMACHER McConnell 235 ADAMS McConnell KELLEY KATSAROS WETZEL 236 HARRIS SMITH POSTLETHWAIT Elliott WISZCZOR 238 CRAFT TARR MORRIS 219 DOMETRONIC BAINER McKAY 218 ZIMMERMAN COX DANLEY LAWSON 217 STULL LAWSON MALARKY PIRAZZO 89 BLAHNIK ROWLAND CULBERTSON 90 SCHNEIDER THOMAS CAGE SHEPARD LOWTHER 97 TUSTIN HUTTER SIMPSON 98 HUTTER MAZZA HUTTER PHILLIPS 105 DEAN DUNCAN LYONS JENNINGS NEMORE BOWMAN 107 THOMAS WHITE DOAK KOPP 112 SEMAN TARR STAGE HARTZOG HARRIS 115 CRUMRINE FREDERICK NASER HEWITT NASER 120 REDLINGER BREESE McCORMICK KLINE 123 MALMBERG 124 BROMLEY FRYE BROMLEY PETHTEL BURNETTE SEMAN 127 YOUNG BECK BEBOUT PETE 132 GLAD MALOOF SMITHSTON ELLWOOD 135 KENNELL SIMPSON McCLEERY KREMBLE PETERSON 141 GRAY McCROWE CROWE MARRABELL BRIGGS 142 MAZE PATTERSON ROSS BRIGHT 149 HART KNESTRICK KEENEY 150 KNESTRICK POLANO
McCONNELL 239 REIGHARD McClosky IVERY 237 FISHER BRONISLAW BRUSCO BEALL SCHLAUPITZ 216 EITNER WHIPKEY JURKOVSKY 215 SCHULTZ SUPLER STALEY BLAKE GOLASKY 214 MARIETTA GOLASKY LIGHTNER VARLEY 211 SNYDER McMULLEN ROACH BAKER 210 DONAHUE FERRY HECKMAN HAYES 201 HORNER MEEKS HUFFMAN 106 GRIFFITH WAZNIAK FERRY PRZYSTUP 113 KELLEY GAYMAN COLLETT HUFF 114 KENNEDY DAVIS DAVIS HARTZOG McDAID BOYAN 121 CRAIG WATSON SWART POLITES ROSS LEWELLEN JENKINS MITCHELL 128 DOLLICK COKELEY PICKENS 131 KNOX EWING RENZ 136 DOLLISH RIZOR STROTT 139 STROTT JACOBS JACOBS 140 BURNETTE DOLAN COUGHENOUR COUGHENOUR 143 ADAMS YOUNG IRWIN TROUTMAN 148 MUNCE PHILLIPS CAGNON 151 HENNEN MUNCE
BERZINSKI 240 HATFIELD FISHER Phillips 241 BRANDON HAYES & GALLAGHER 242 JACKSON BRADLEY BRANCZEK GALLAGHER 243 GURNEY Seals DRAUCKER FRENCH 244 GARRETT PEARCE 213 DAWSON TURCKE SEIBEL 212 KATSAROS ROUX ERVIN 209 RAY ROUX CUNNINGHAM TREE SMIDER 202 WOLFE GREGG SALSBERRY 200 FREEMAN MOORE PROSSER 191 MUMBOWER HUFFINE HARDING GRIFFITHS TOOTHMAN 190 GRIFFITHS PEARSON Rodgers TARR 181 CHURCH LONG McDONALD ELDER CAIN ANDERSON 180 CARPAN HOPKINS POLITES SWART 122 BOWMAN MAYS McGREW 129 OLINGER ROUP HIGGINS 130 MOORE ROCHE ANDERSON ROCHE HORNER FISHER 137 MASTRANGELO BELL HAWKINS NASER 144 NASER HARPS 147 DIAMOND ADAMS ADAMS HEWITT HERMAN LOVEJOY 152 LOVEJOY McVAY
DIAMOND 251 HENDERSON BROCK Williams 250 BEATTY HIGGINS 249 TOCCI TARR SHANKOVICH 248 HUTTER KIRSCH BLACK MILLER LAUGHLIN 245 CHROPEK COLVIN 208 GURNEY TAYLOR MARTIN ASHMORE 203 MILLER BARKER 199 TOLAND RAVOIRA BAYLES HAYES MORGAN 192 LaSALVIA MUMBOWER JONES DONALDSON 189 MALOY JOLLEY LOVEJOY BUCKLEY 182 ANDERSON JONES MIERCZYNSKI McNEELY 173 McNEELY HOPKINS EWART 172 HOLMES WHARTON DEVORE 165 CLUTTER MASTRANGELO MACRE 138 BODNER MALOY ROOD HERMAN WINKIVOIS 145 STEELE HARRIS 146 WRIGHT SHARPNOCK 153 CHAPMAN
252 RITTER 253 PROKELL ROWE ROWE 254 Common KATOCS LUNN Common MITCHELL HOPKINS DeSENSI ROOD & ROBSON 247 ADAMS BROOME 246 MESSINA LINTON ELLIS DARGUS McCARTNEY 207 SLUSHER HICKMAN GETZ BYRD MOLINKO NEWMAN BEDILLION 198 NEVILLE HEINEY PIATT JURKOVICH 193 HEINEY BROCK BROWNLEE PEEL 188 BEDILLION HERRON 179 FARABEE BARNES FARABEE LINDLEY 174 DAY DIXON ADAMS 171 CAMP KELSO DONALDSON DONALDSON 166 HAUGHT BENNETT WOOD SPEECE 164 Jolly WISE NOBLE 159 HARDEN SARGENT MARCH 158 OWENS McDONALD BELL LYLE 154 PEPLER STAINBROOK
BIRD & BENSFORD 263 BIRD 262 GORDON MARTIN Hold PETKO 261 255 LUNN ALLEN BALL WISNIEWSKI CAHILL MURPHY BABIARZ 256 PICKENS BAWOL BAKER 257 BYERS DePAOLI PUGH HUTTER 258 WILCOX MULL 204 ZIGLER COLE BAKER 197 LEVERS ANDERSON CROWE LEVERS SINGLETON 194 FAUST RUNYON WEISTER 187 BRUNELLA HANCHER BRYNER 184 CAUMO MARTIN 183 ALLEN RUSH MARTIN 178 HARRIS SUTTON PARK 175 YATES TUCKER ALEXANDER ALEXANDER 170 FILBEY IAMS 167 FILBY RIDDLE McWREATH ALLISON 163 RIDDLE LEE BRANCZEK BAINBRIDGE 160 CAIN McCONNELL BEDDOW 157 WHITE SEIBERT CHRISTMAN CUNDALL 155 SPENCE SPENCE
BIRD PRESKY 265 MAREK Kelley ZEEMER 264 MASON DAY DAY BURT 260 THOMPSON LINDLEY JONES WINTERS ANTHONY PETKO 259 McQUAY CARTER BEDMAR HUFFORD STANLEY 206 KELLEY BRADIGAN STEELE 205 STEELE DUNN CAGE 196 PAYTON MILLER PUGH TREE SOBO 195 PUGH SABO HILLBERRY MITCHELL MITCHELL FENDER 186 OBERDICK REIHNER FENDER McKAHAN LOUGHMAN 185 JOSEPH BAILS OHS YATES BAILS 177 JOHNSON DENSON BOOTH THOMAS 176 THOMAS SILVERS 169 BONUS WARD ADAMS IAMS 168 PICKENS EDGAR RANOVICH BLAIR 162 DEVENNEY GROUPE GORDON TANNER POSTLETHWAIT 161 HOPKINS STEVENSON WARD 156 MOWELL CLAUSER

SECTION # 10

WEST SECTION

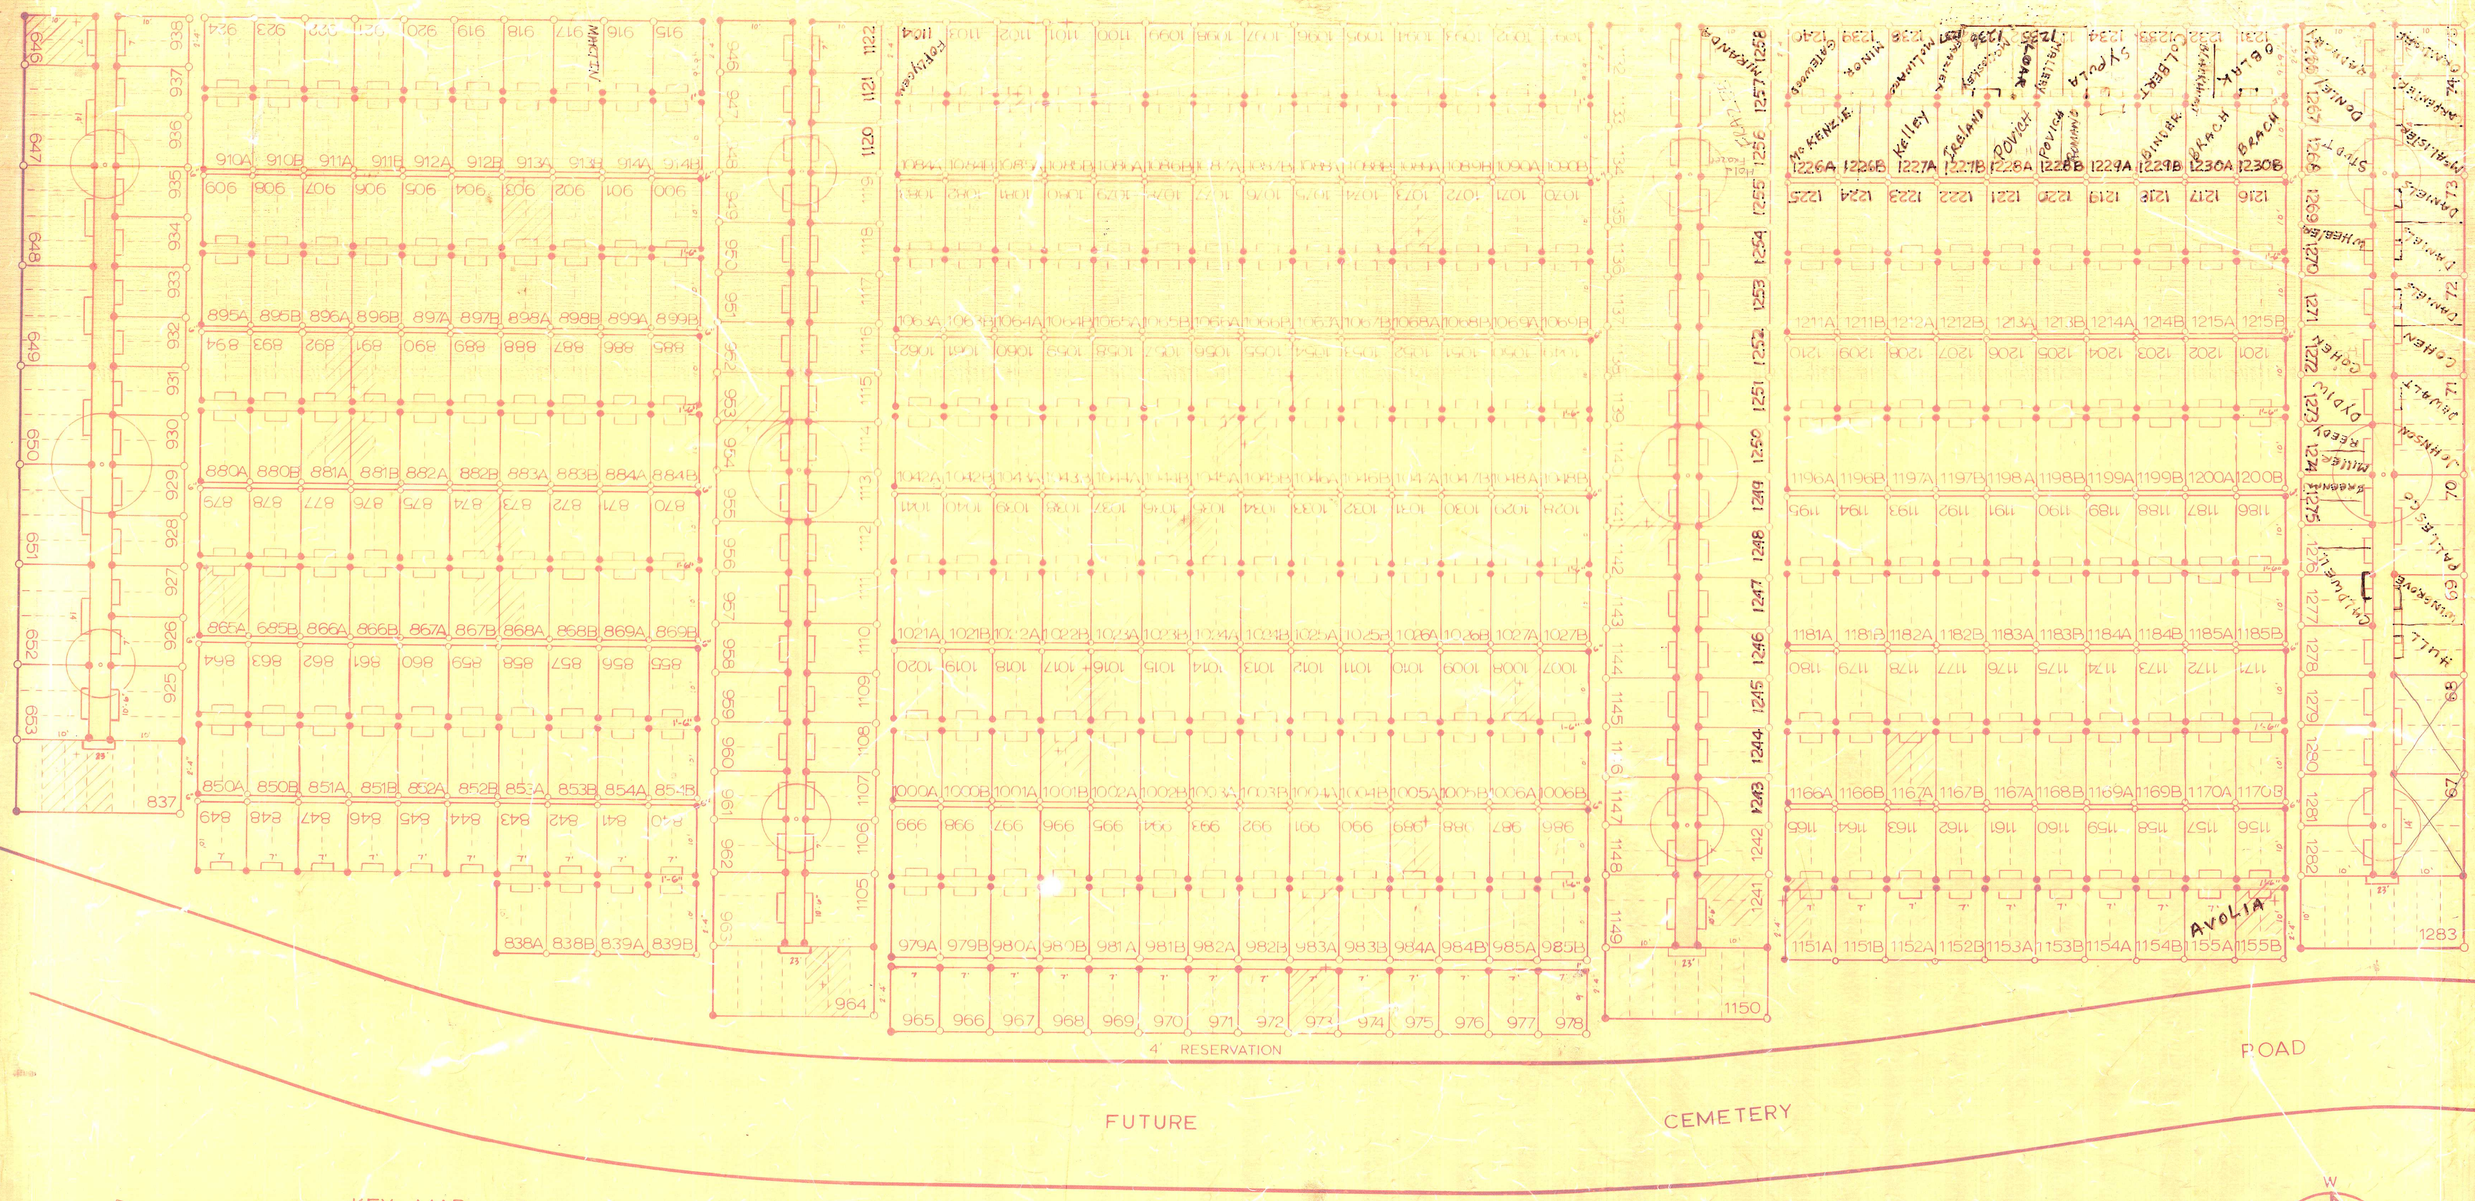

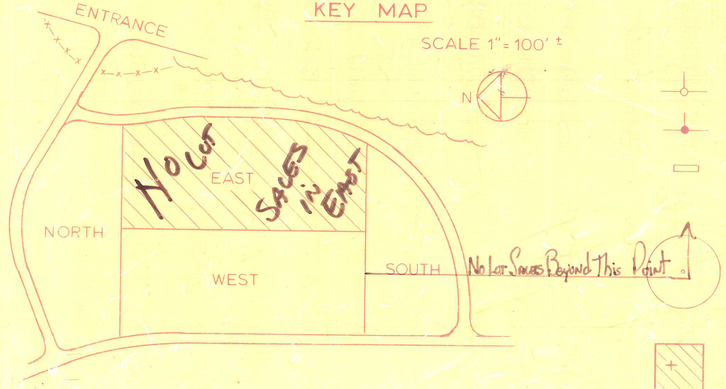

LEGEND

- NUMBER MARKER LOCATION
- BLANK MARKER LOCATION
- MONUMENT
- PLANTING AREA
- PROPOSED TREE LOCATION
- EXISTING TREE LOCATION AND OFF-SALE LOT

Section 11

East Part

Washington Cemetery

Washington , Pennsylvania

ALL GRAVES ARE 3'-6" x 9', 10', 11'

PLAN SUMMARY

LOT SIZE	LOTS	GRAVES
2 - GRAVE	516	1032
3 - GRAVE	6	18
4 - GRAVE	14	56
7 - GRAVE	4	28
TOTAL	540	1134



SCALE 1" = 10'

COPYRIGHTS

GREVER & WARD, INC.
Cemetery Planning
3802 N. Buffalo Street
Orchard Park, N.Y.

#944
#663
R10-9-85 ADH
8-11-88 MVD



KEY MAP

PLAN SUMMARY

LOT SIZE	LOTS	GRAVES
2 - GRAVE	169	338
3 - GRAVE	15	45
4 - GRAVE	58	232
5 - GRAVE	2	10
6 - GRAVE	18	108
8 - GRAVE	2	16
9 - GRAVE	1	9
TOTAL	265	758

ALL GRAVES ARE 3'-6" x 9', 10', or 11'.

LEGEND

- NUMBER MARKER LOCATION
- BLANK MARKER LOCATION
- MONUMENT
- PLANTING AREA
- PROPOSED TREE LOCATION
- EXISTING TREE LOCATION AND OFF SALE LOT

Section 11

North Part

Washington Cemetery

Washington , Pennsylvania


SCALE 1"= 10'

S E W NORTH

#944 #683 R10-9-85 8-11-80 ADH MVD


COPYRIGHTS

GREVER & WARD, INC.
Cemetery Planning
3802 N. Buffalo Street
Orchard Park, N.Y.

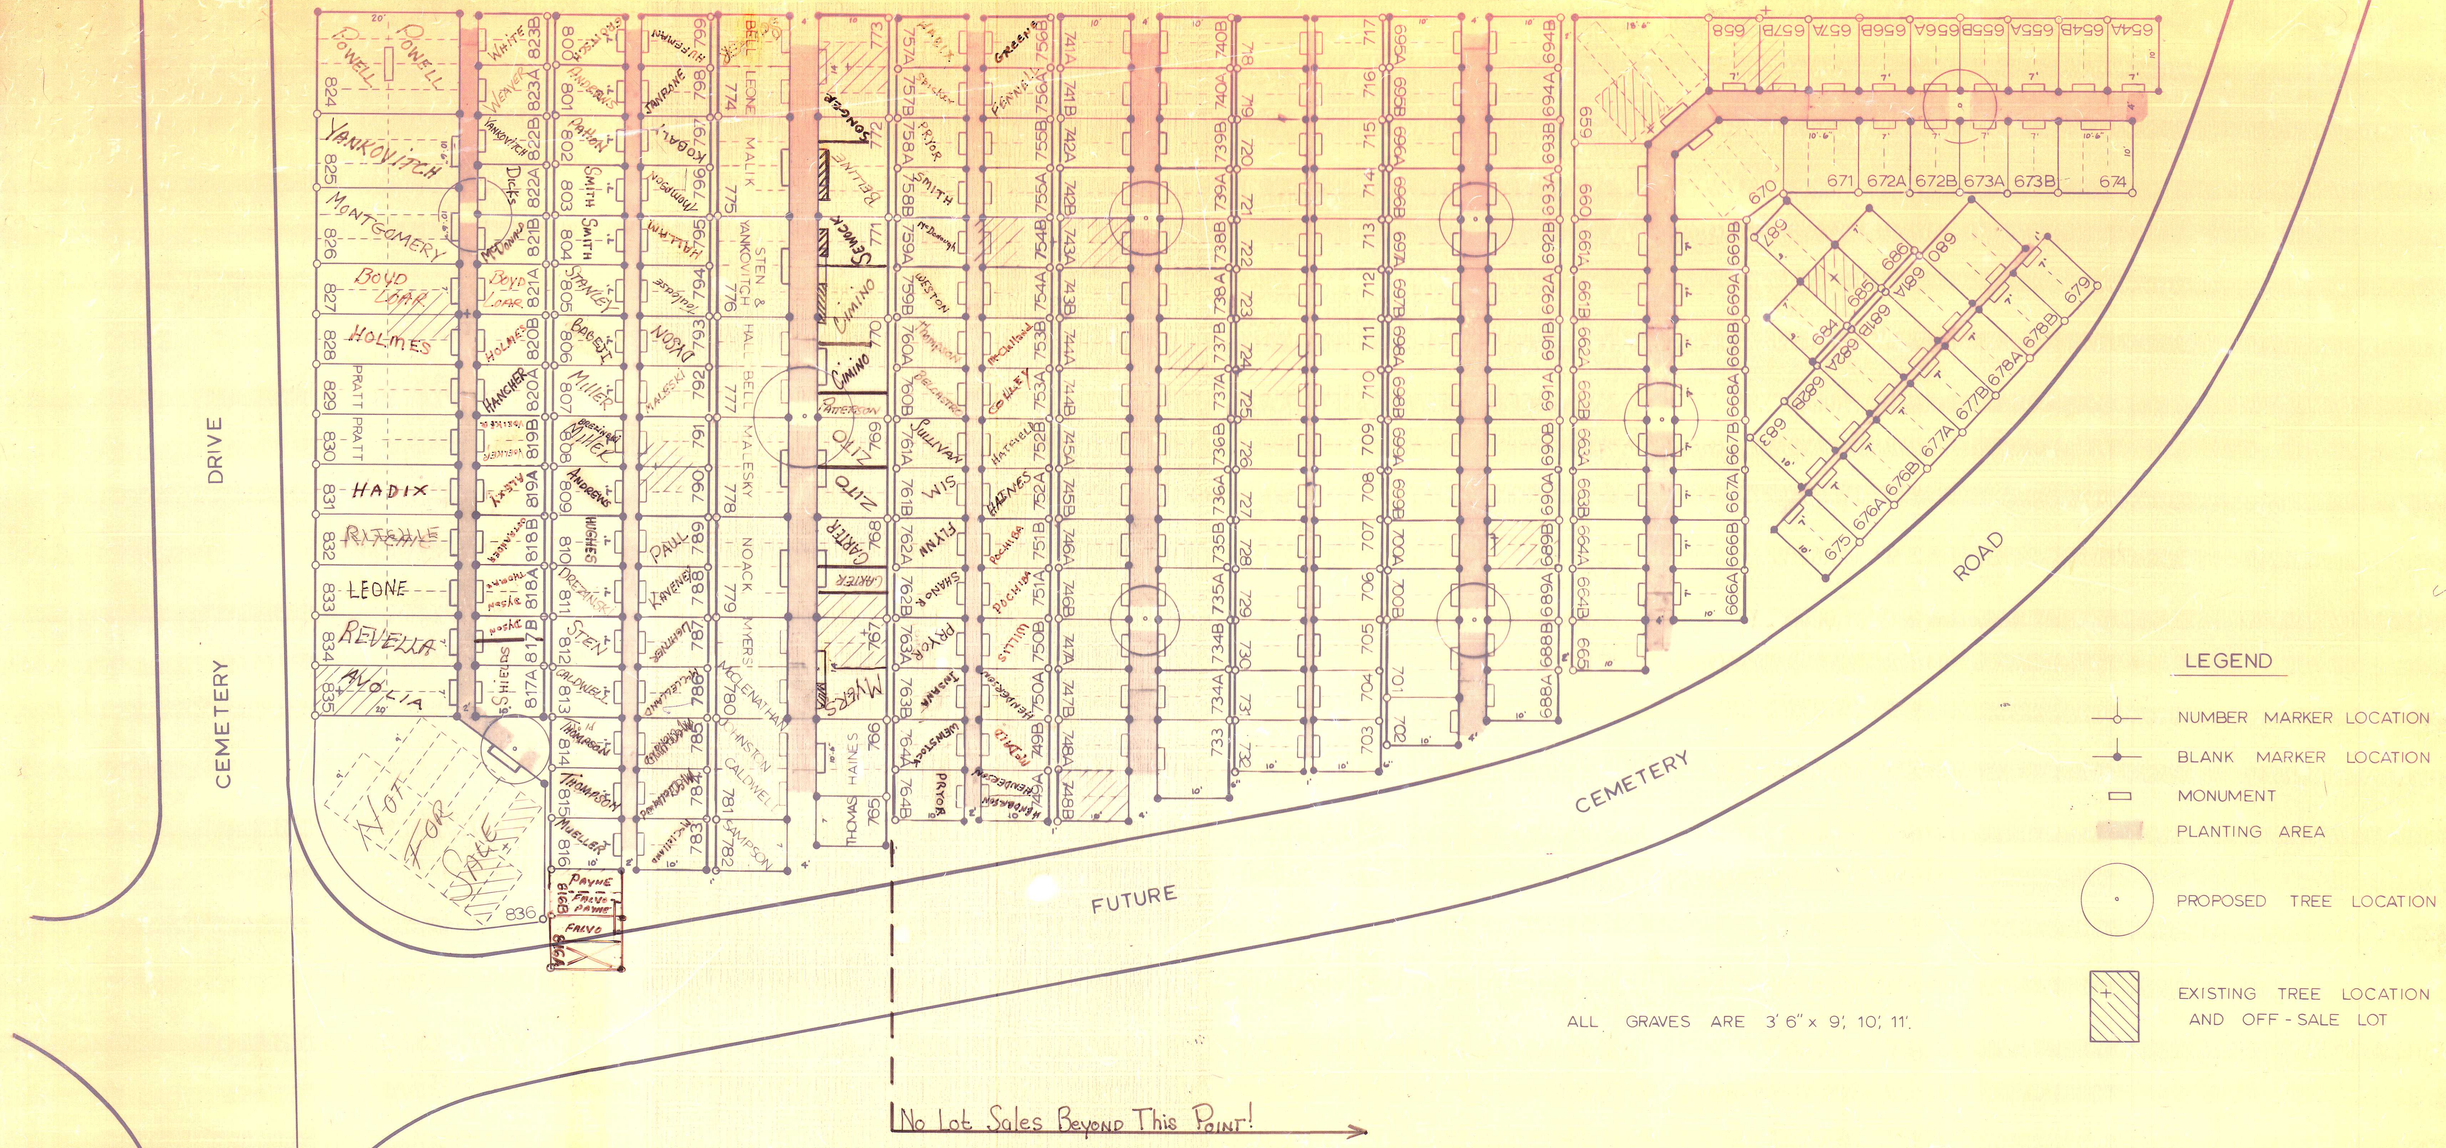

KEY MAP

SCALE 1" 100' ±

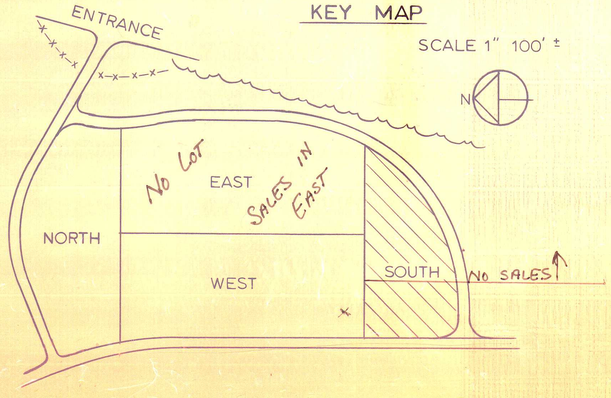

Section 11

South Part

Washington Cemetery

Washington , Pennsylvania

PLAN SUMMARY

LOT SIZE	LOTS	GRAVES
2-GRAVE	224	448
3-GRAVE	8	24
4-GRAVE	20	80
5 GRAVE	1	5
6-GRAVE	2	12
8-GRAVE	1	8
ESTATE	1	14
TOTAL	257	591


NORTH
W E
S

SCALE 1" = 10'

COPYRIGHTS


GREVER & WARD, INC.
Cemetery Planning
3802 N. Buffalo Street
Orchard Park, N.Y.

#944 #683 R10-9-85 8-11-80 ADH MVD

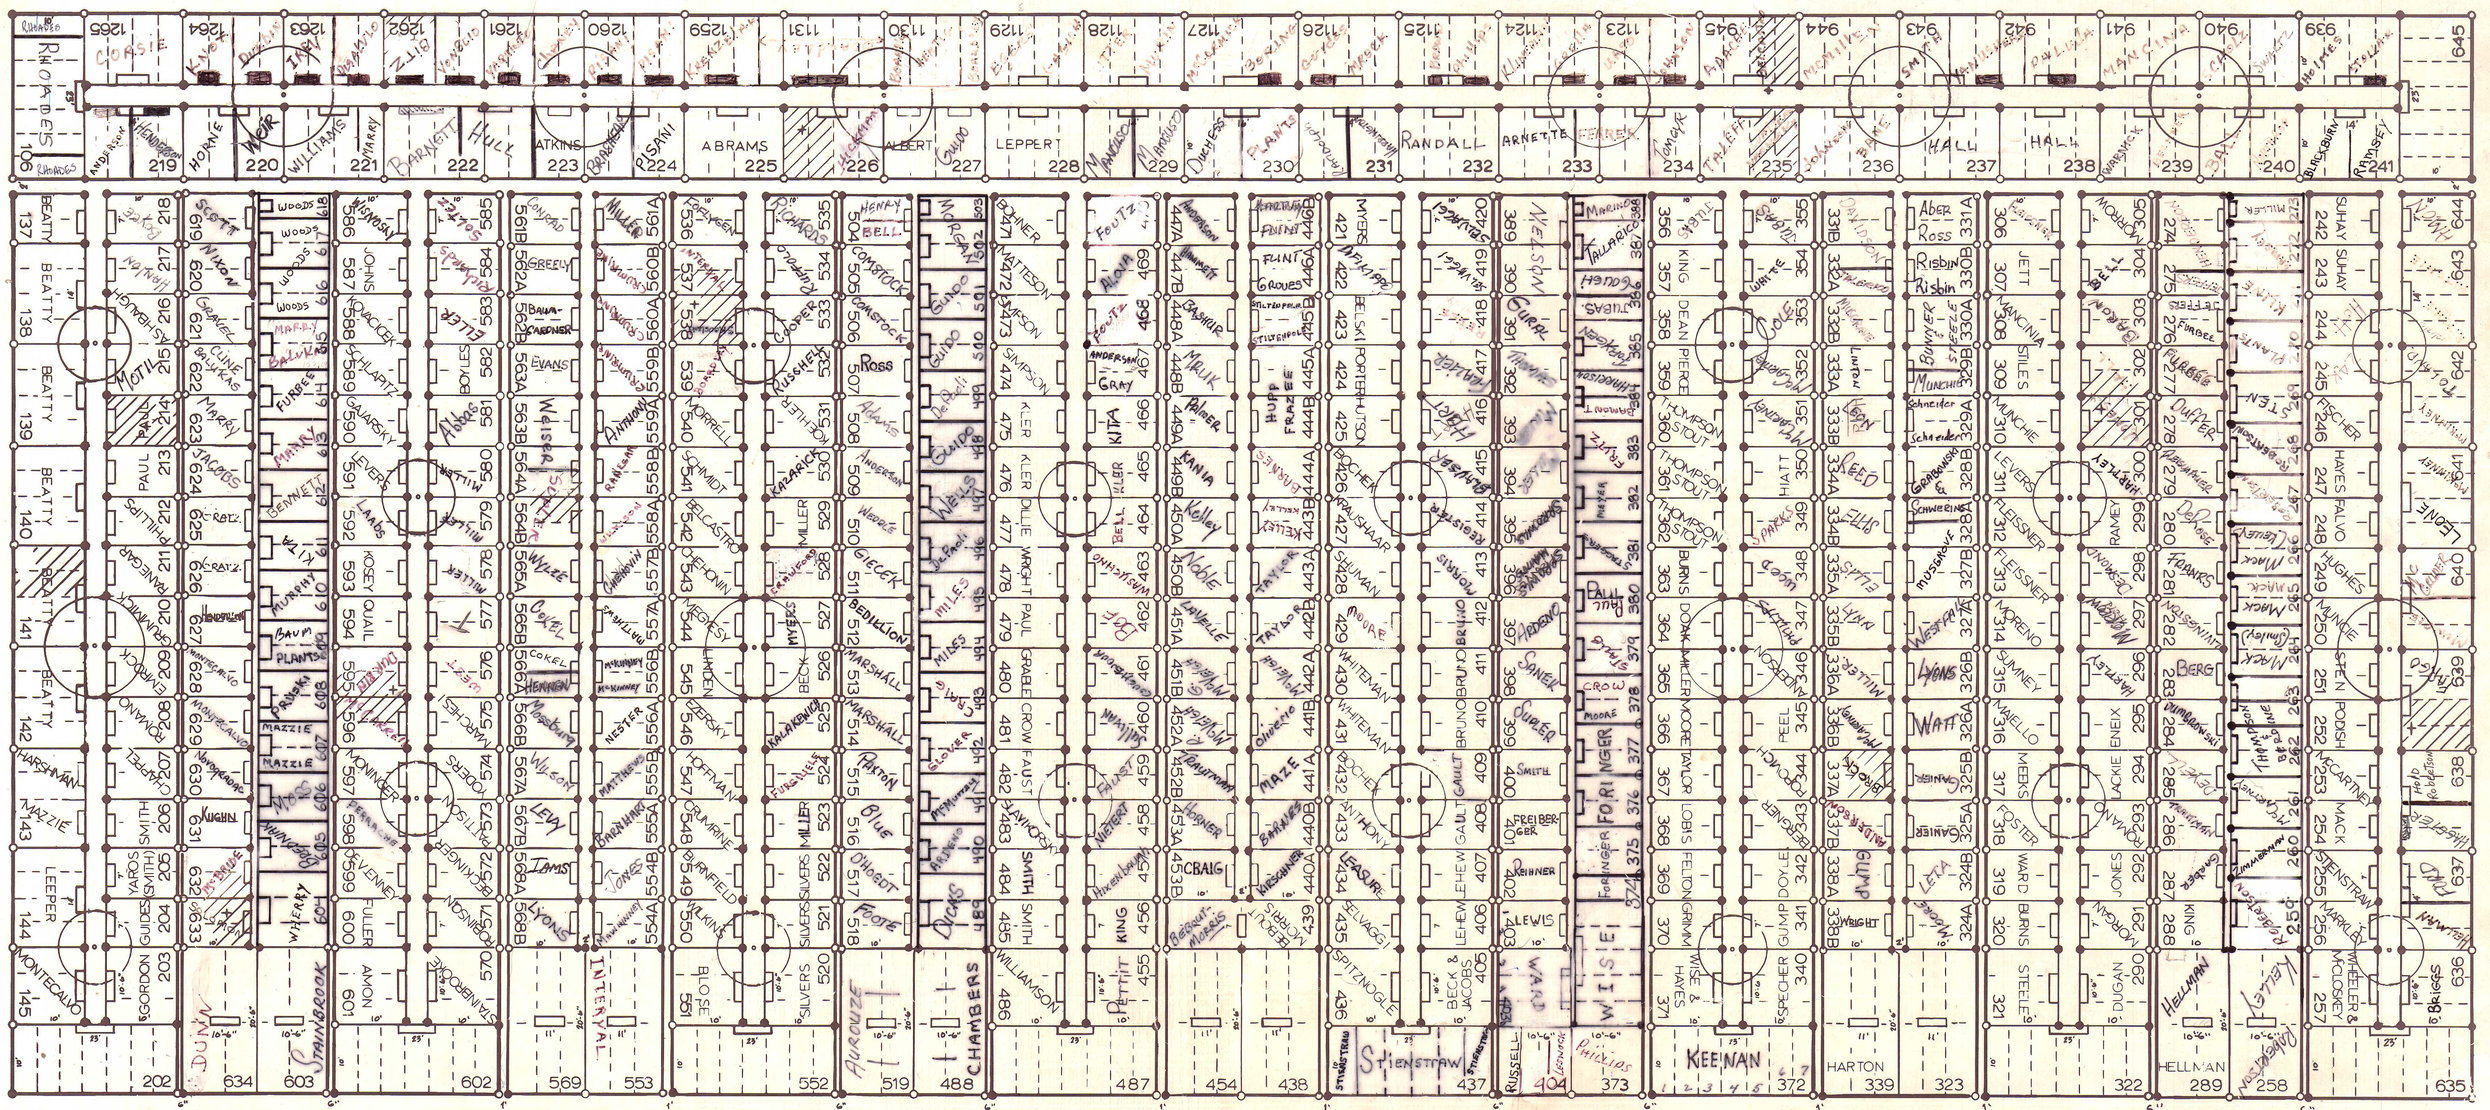

KEY MAP

SCALE 1" = 100' ±

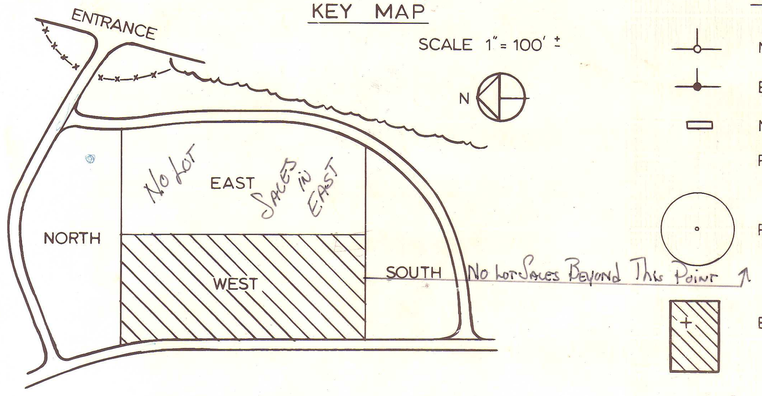

LEGEND

- NUMBER MARKER LOCATION
- BLANK MARKER LOCATION
- MONUMENT
- PLANTING AREA
- PROPOSED TREE LOCATION
- EXISTING TREE LOCATION AND OFF - SALE LOT

Section 11

West Part

Washington Cemetery

Washington , Pennsylvania

ALL GRAVES ARE 3'-6" x 9', or 10' UNLESS OTHERWISE NOTED.

PLAN SUMMARY

LOT SIZE	LOTS	GRAVES
2 - GRAVE	424	848
3 - GRAVE	16	48
4 - GRAVE	67	268
6 - GRAVE	6	36
7 - GRAVE	10	70
TOTAL	523	1270

N
E
S
W

SCALE 1" = 10'

COPYRIGHTS

GREVER & WARD, INC.
Cemetery Planning
3802 N. Buffalo Street
Orchard Park, N.Y.

#944 R 10-2-85 ADH
#683 8-11-86 M'D